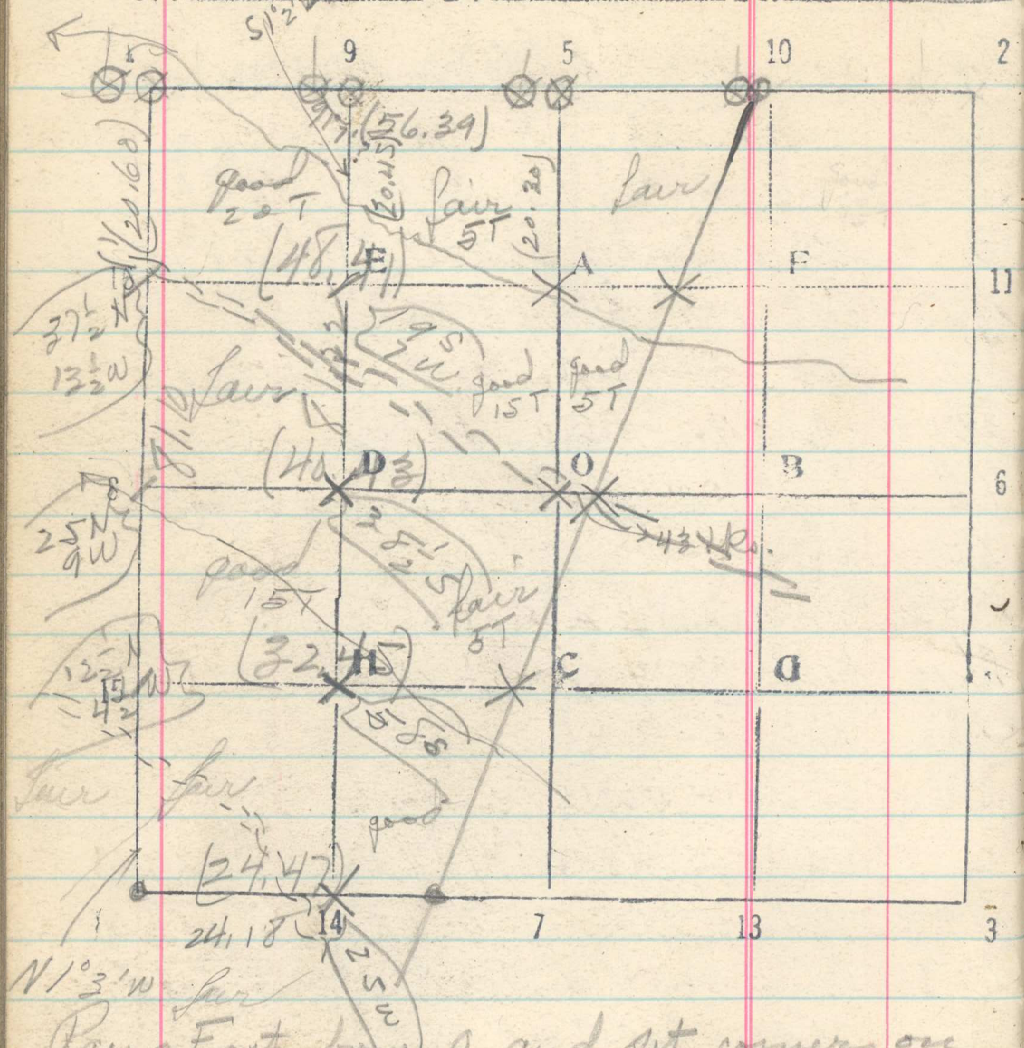

Sec. Sec 1 T. 1 N R. 3 E

S 1/2

Run East from 0 and set corner on Boundary between Lots 4 & 5.

Run East from H and established corner on Boundary between Lots 4 & 4

9/10 Line 4 - C. C. from B. S. on Sec. cor. 2-3-10-11 run East between 1 & 12

Set 20

16 Ridge N W - S E.

24.18 C C on line

9/15-11 Line 4 — 1 North between 1 & 2

Set 20 - 40 - 60 (No sign found / Hard

6 Ravine S W / 15 Ridge N W - S E / 38 Ravine N W

22 Ridge N 70° W - S 70° E.

8/10 Sec. cor 1 & 2 bears N. 18 lks.

9/12 Line 9-14 South thru West half

Set 20 - 40 - 60

10 Ravine Shds N 60 W. / 30 Ridge N W - S E

55 Ravine Shds N W.

8/22 1/16 cor 14 on line

9/17 Line 5 — 0 South thru center

20.56 Set 1/16 cor. 7

40.82 Set 1/4 cor. 0. 43 lks from Boundary

Run East from H to established corner on Boundary between Lots 5 & 6