


39

Sec. 7

T. 12 N

R. 35 E

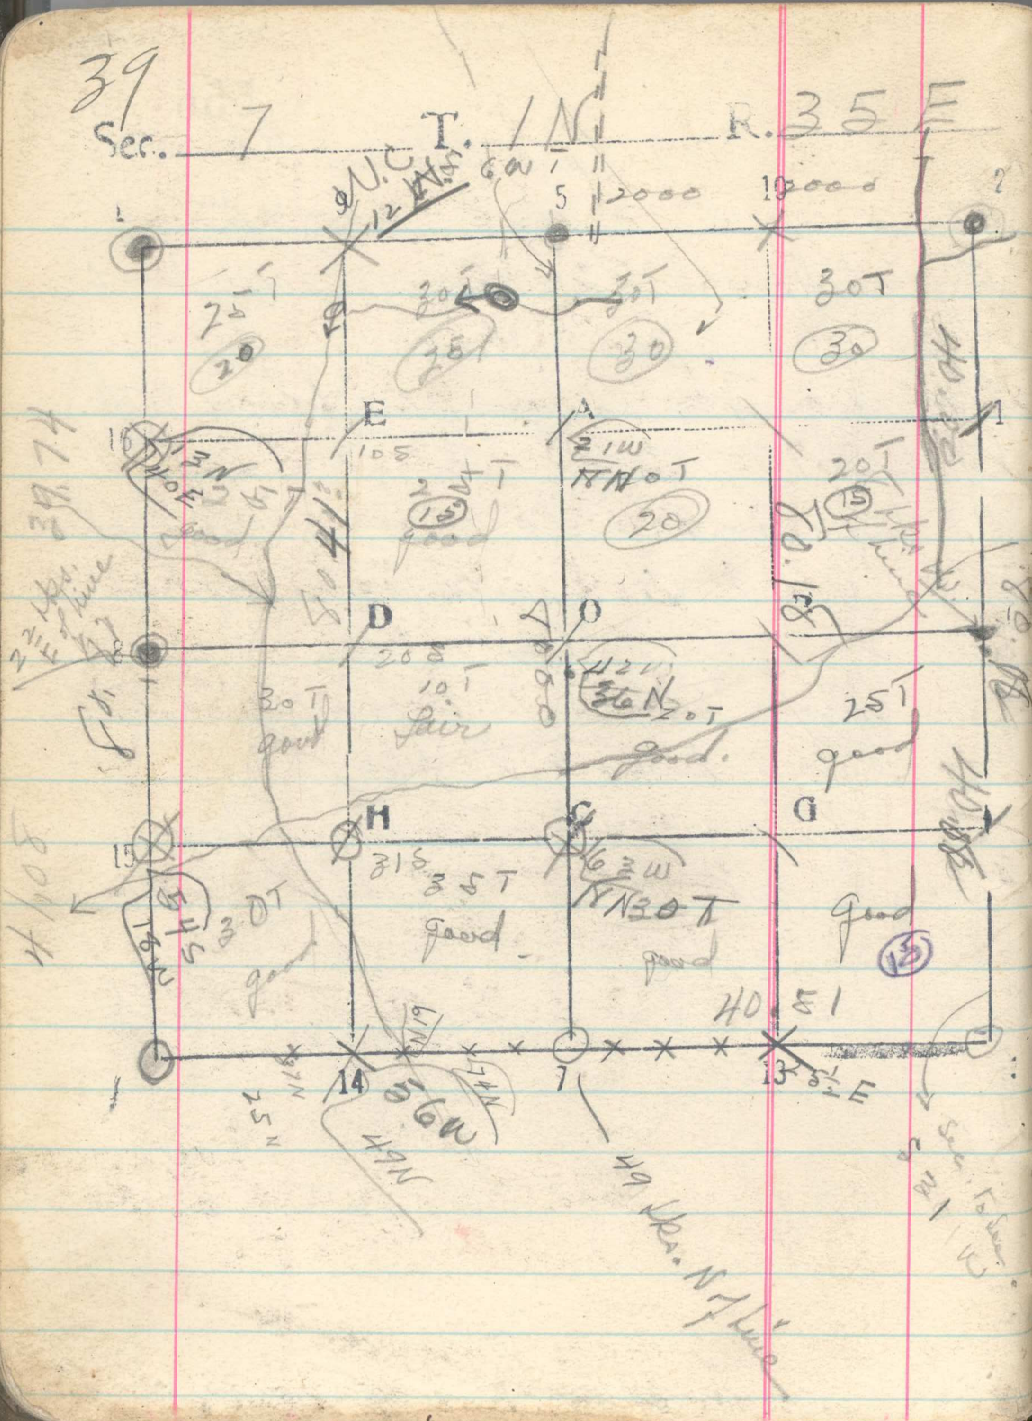

557

- 10/14 line 1-8 South on township  
 line between 7+12  
 lot 20 / 30 Prairie Sheds S 70 E  
 39.74 old 1/4 cor. near E 81 lks.  
 Good mound of stones with rock marked,  
 not very plain
- 10/14 line 8-4 South on township line from cor. lot. 7+12  
 lot 20 / 25 McKay Creek S 70 W.  
 41.08 sec. cor. 7-12+13-15 near W. 36 lks.  
 10/14 line 4-7 East between 7+15  
 lot 15-20-25-30-35  
 78.97 1/4 cor. near N 98 lks.  
 Prairie shed west on township line.
- 18/15 line 9-14 South thru west half.  
 lot 20-40-60  
 53 McKay Creek Sheds West  
 80.40 1/4 cor. from west near E 18 lks.  
 10/16 line 5-7 South thru center  
 lot 20-40-60  
 55 McKay Creek Sheds west  
 180.00 1/4 cor. near W. 54 lks.