


6
 Corners to be changed 1-16-8-15-4

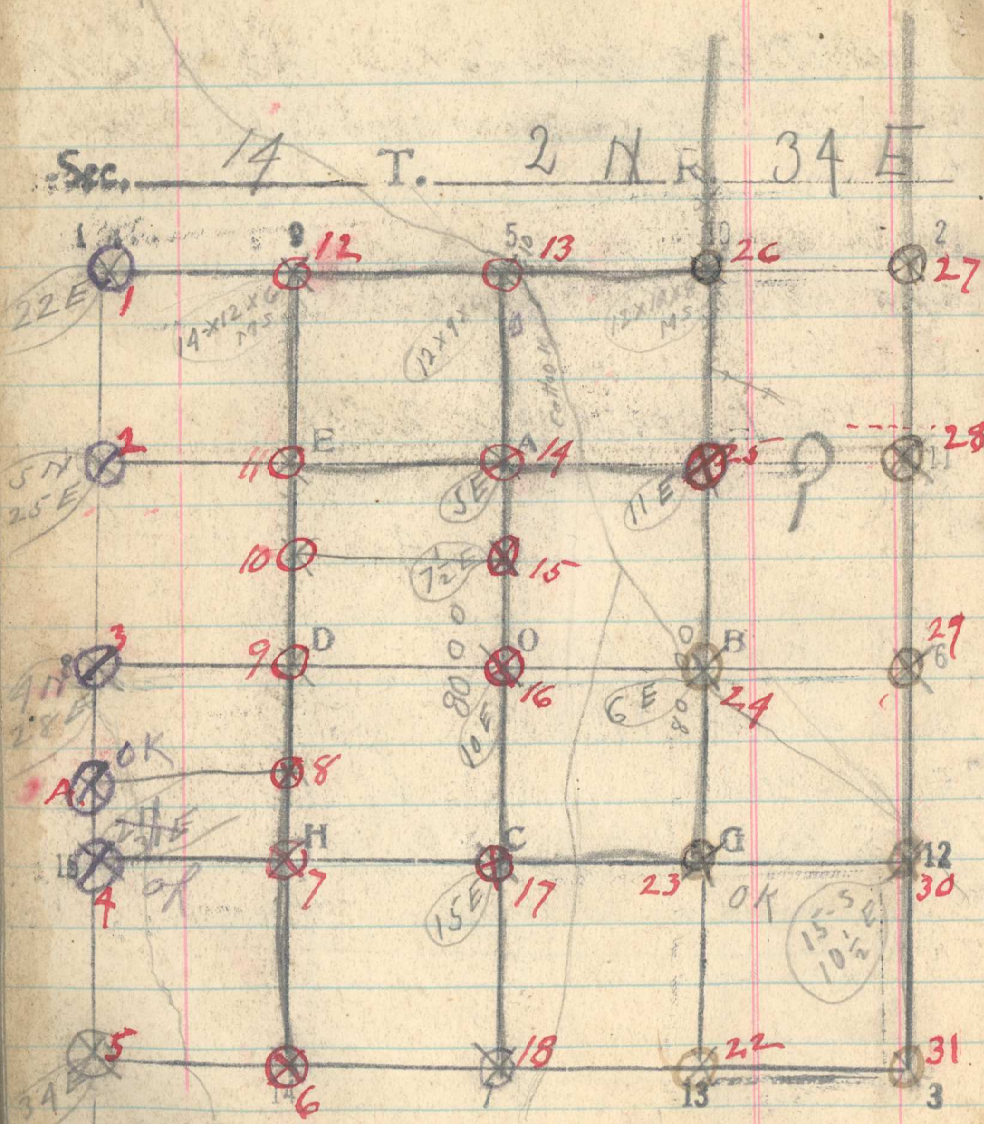

Friday March 7 1919

482

set corners

South through Center Sec 14 20-30-40-60

80.00 chs Temp cor 7 sec 14 bears 20. lbs E

North through East 1/2 Sec 14

20.00-40-60 set corners

41.00 chs Cr sheds NW

80.00 chs 1/16 cor 10 bears 18 lbs E

North between S. 15 & 14 line 3 & 4

Continuing line 6-2 Sec. 22

Set 20-40-60

20 fence N 50 E - S 50 W

35.25 Creek 10 lbs. N. 20 W.

38.35 fence E - W

38.81 " "

80 Set temp cor. 1