


18

Sec. 34 T. 2N R. 34E

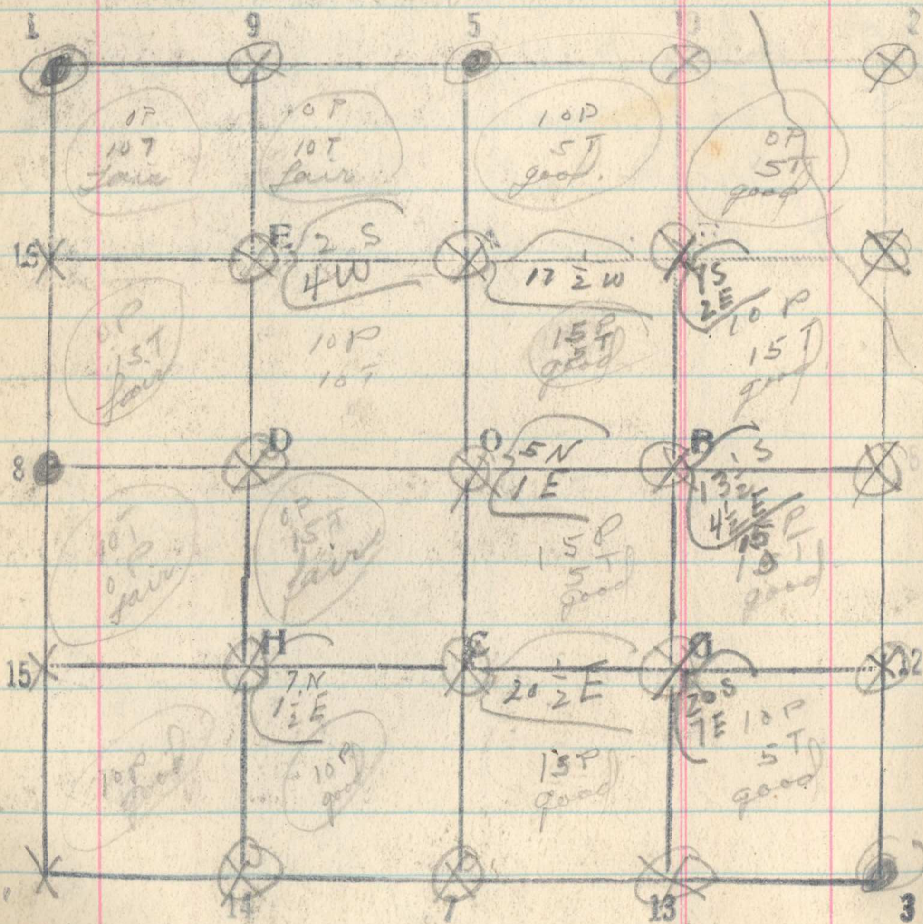

4/24

494

Line 9-14 South from West half

15 Road N 30 W - S 30 E

19.97 old  $\frac{1}{16}$  cor F bears East 16 lks29.98 old  $\frac{1}{16}$  cor D bears East 25 lks60.04 old  $\frac{1}{16}$  cor H bears East 36 lks79.96  $\frac{1}{16}$  cor. 14 bears East 50 lks

4/24 Line 7-5 North from Center

2.50 Small spring 3 chs East of line

20. old  $\frac{1}{16}$  cor bears W. 16 lks.

37.50 Single wire fence corner N 30 W - E

34 good spring 3 chs. East of line. Shd. North

39.95 old  $\frac{1}{4}$  bears F 8 lks60. old  $\frac{1}{16}$  cor H bears E. 31 lks.80  $\frac{1}{4}$  cor 5 bears E 18 lks.

4/25 line 10-13 South from East half

Sit 20 - 40 - 60

80.29  $\frac{1}{16}$  cor 13 bears E. 9 lks.