


Sec. 10 T. 2 N. R. 34 E

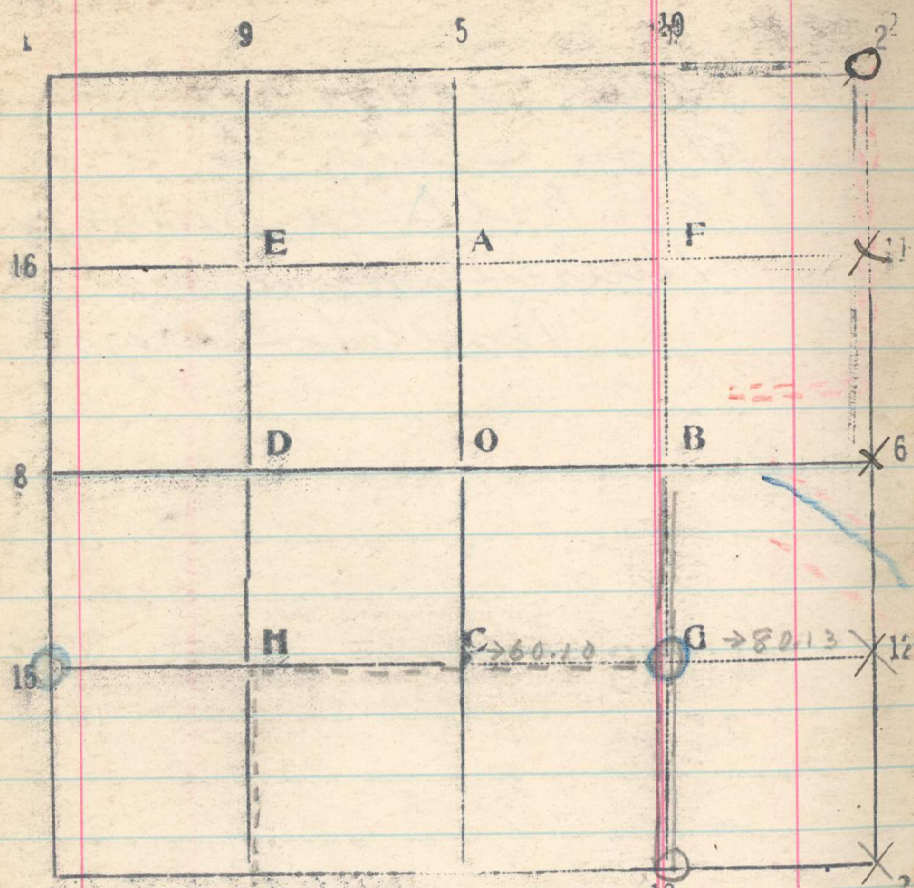

East thru S. 10 cor 15 to cor 12
 20.29 fence corner. South and East
 60.10 old $\frac{1}{4}$ corner bears N. 10 Ws.
 80.13 Set stake $\frac{1}{4}$ cor. 12 temporary.
 13 Ws N of line
 For line 3-2 see page 6.

Wests between 14 & 15

39.97 old corner 13
 Set W. C. 30 ft East

518