


Sec. 22 T. 2N R. 34E

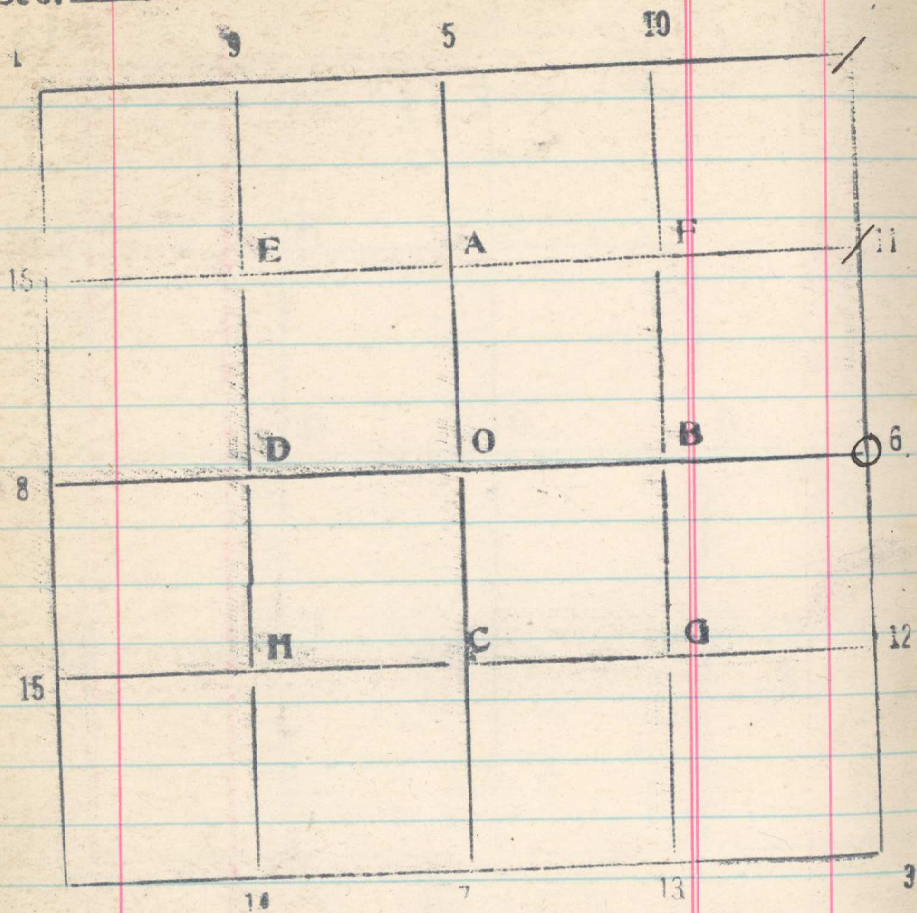

North between S<sub>2</sub> 22 + 23. from cor.

20 Set temp. cor. 11 + 15.

40 set temp. corner of section.

40.97 Old temp. sec. cor. bears E. 34 lks.