


Sec. 15 T. 2n R. 34E

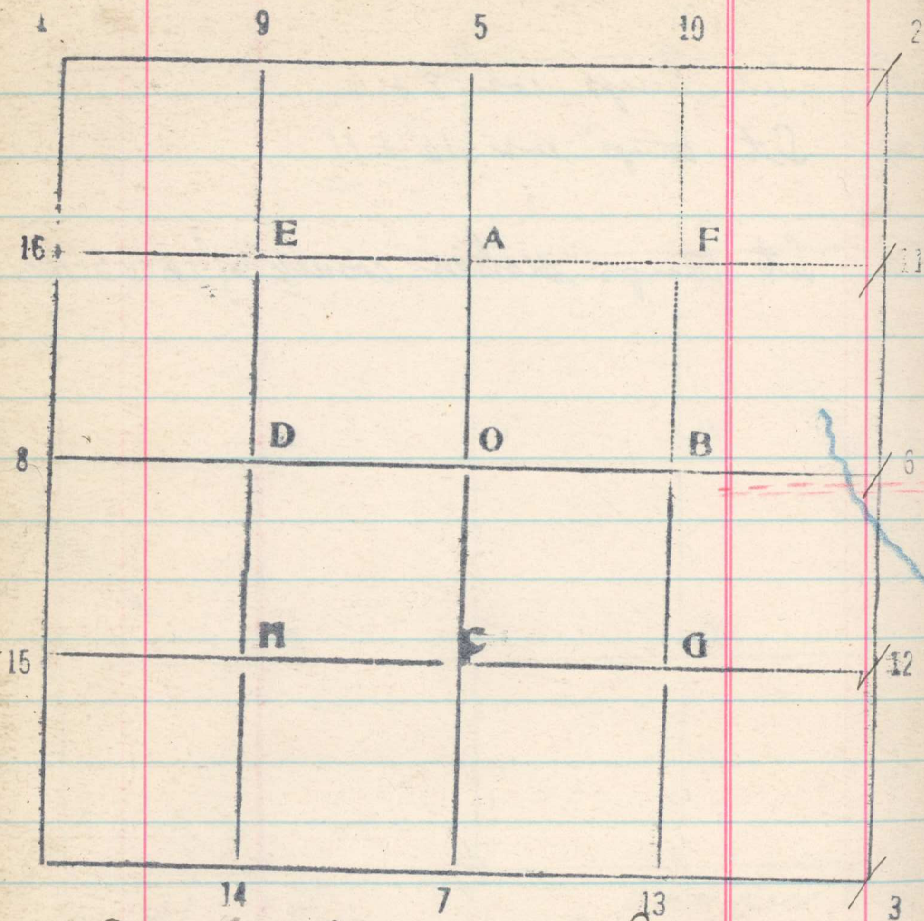

See page four (4) for line 3-2