


22

Sec. 19 2 N 35 E

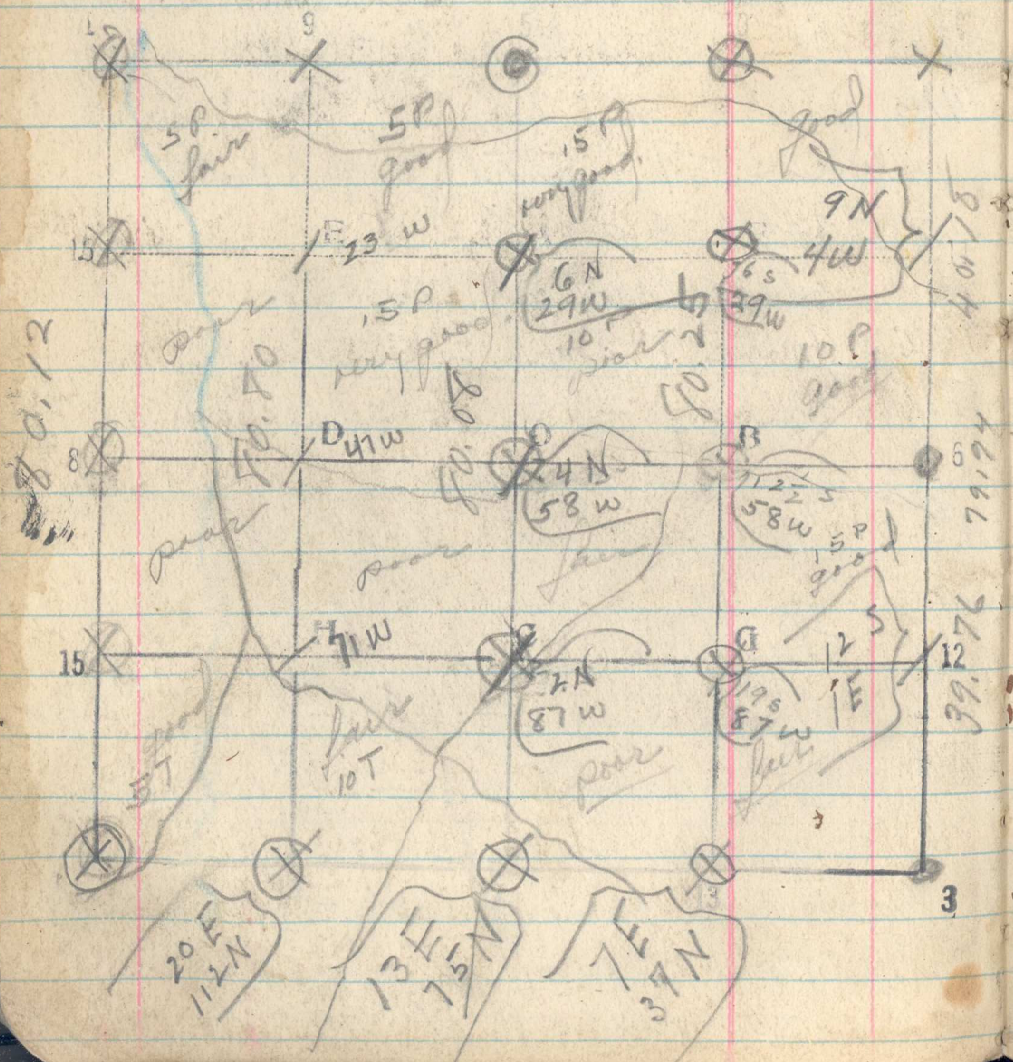

5/29 Line 9-14 South thru East half 498

Set 20-40-60.

10 Jay Coulee Sheds NW. 40 miles W.

63 Buckaroo Creek Sheds North West.

91.70 1/6 car 14 bears W. 93 lbs.

5/30 Line 5-7 South thru center

Set 20-40-60

35 Summit 45 Bears steep rocky summit

63 Coulee Sheds SW.

79.50 Creek (Buckaroo) 10 Miles Sheds NW.

80.08 1/4 car. 7 bears W. 116 lbs.

5/1 Line 10-13 South thru East half

Set 20-40-60.

5. Creek 2 Miles NW.

80.25 1/6 car 13 bears W. 116 lbs.