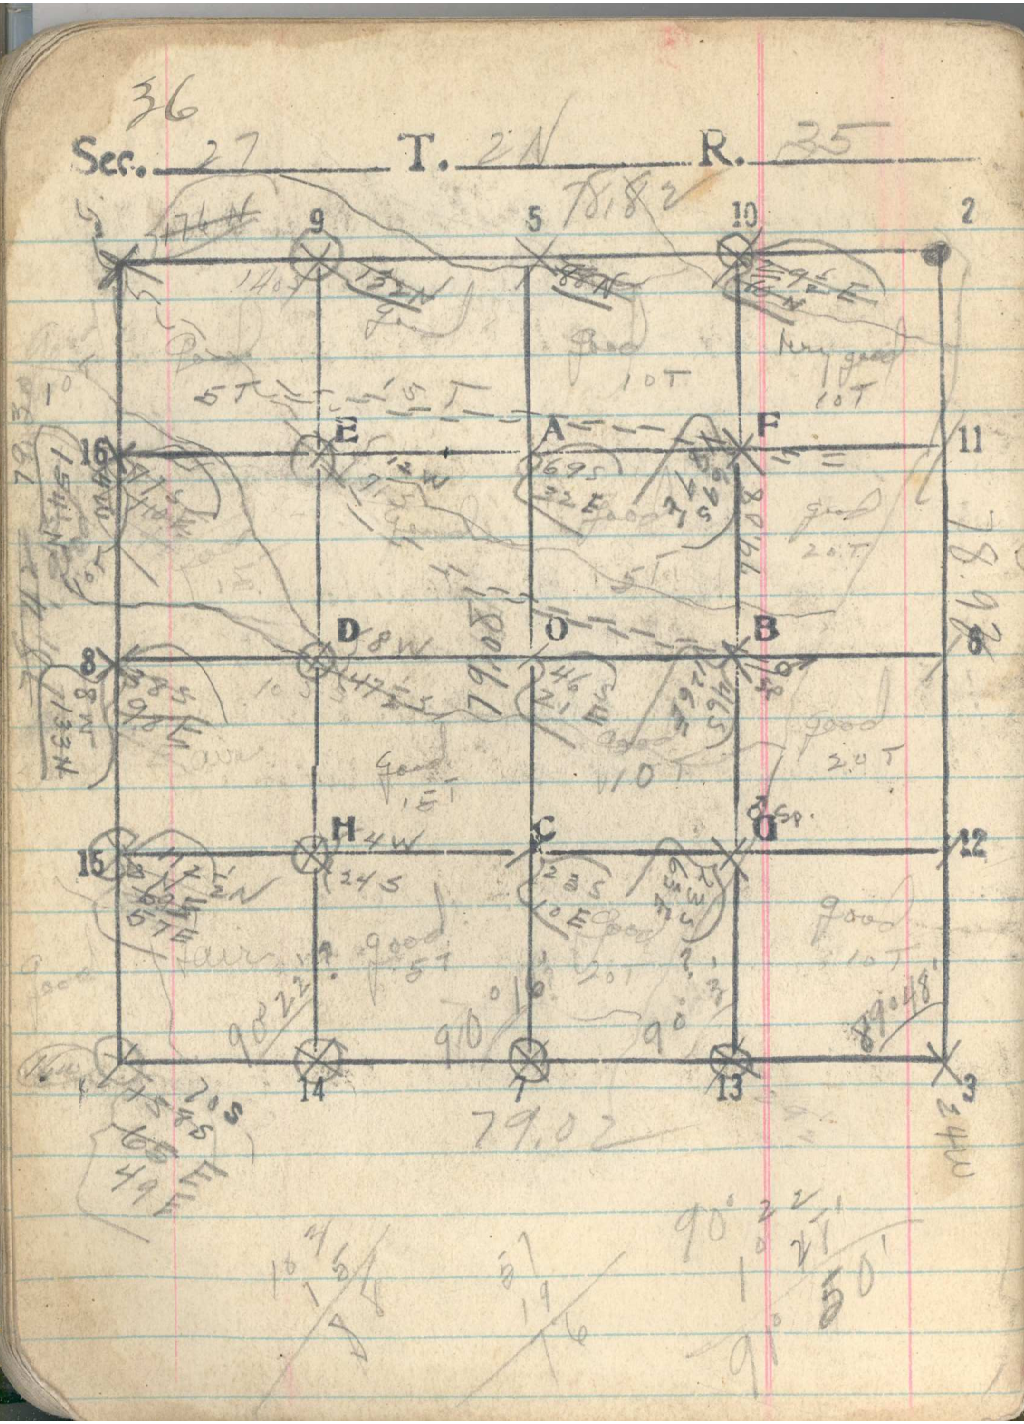

51c

8/19 Line 4-1 North between 27 & 28

Sp Sec. 34 T 2N R 35E Book II

8/21 Line 18-16 Northern Cut half

Set 20-40-60.

17 Squaw Creek - S 20 E / 30 Rainier E

47 Rainier - East / 72 Rainier E

79.04 1/16 Cor 11 bears E 25 2 lks.

8/28 Line 7-5 North Bdry Center

Set 20-40-60

Rainier 6 E / 35 E / 52 E / 72 E

79.08 1/16 cor 5 bears E 42 lks.

8/29 Line 14-9 North Dist. 79.02 Cor bears W. 16 lks.

Set. 20-40-60.