


Sec. 6 T. 2N R. 36E

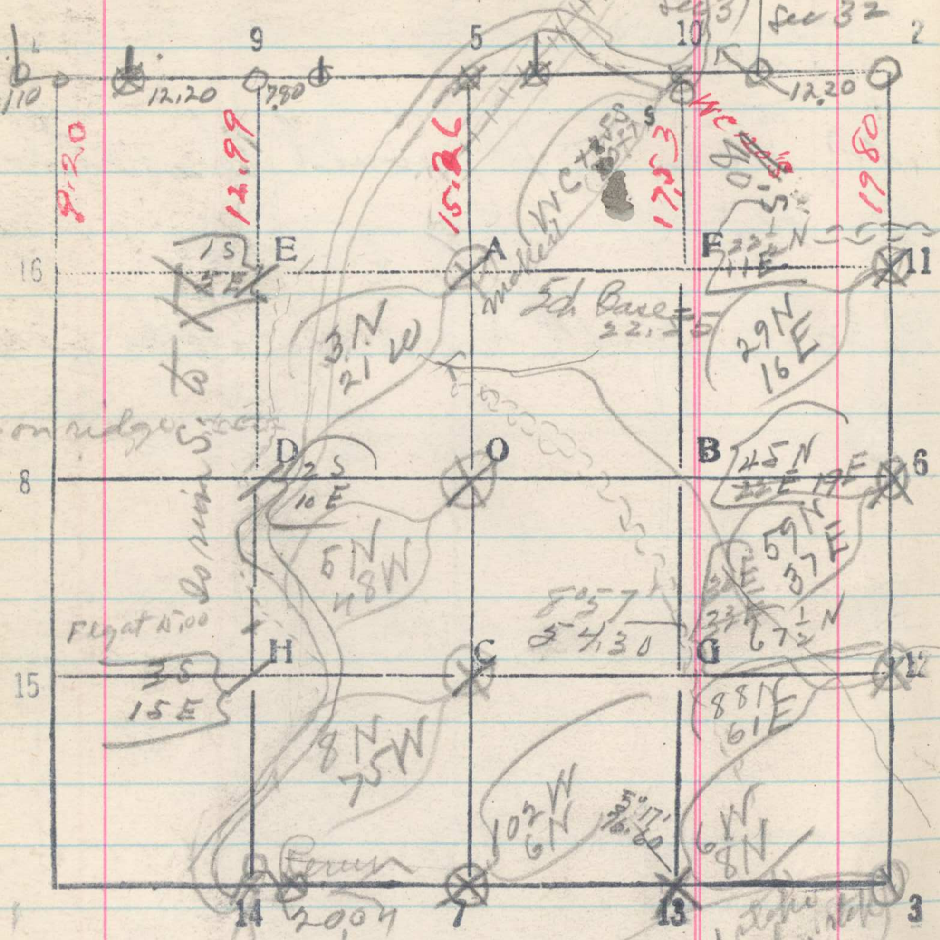

1/8 line 9-14 Continue C.E.R
 line thru West half from bench pt.
 80.04 1/16 Cor. 14 bears E 20 lks
 1/12 line 10-13 South thru East half
 let 17.53 - 37.53 - 57.53
 76.63 (-90) 1/16 Cor. 13 bears E. 44 lks

WC 30' N
 WC 220' E

50E-4N from 1st hole
 8W-12N from other hole