36

Sec. 18 T. _____ R. _____

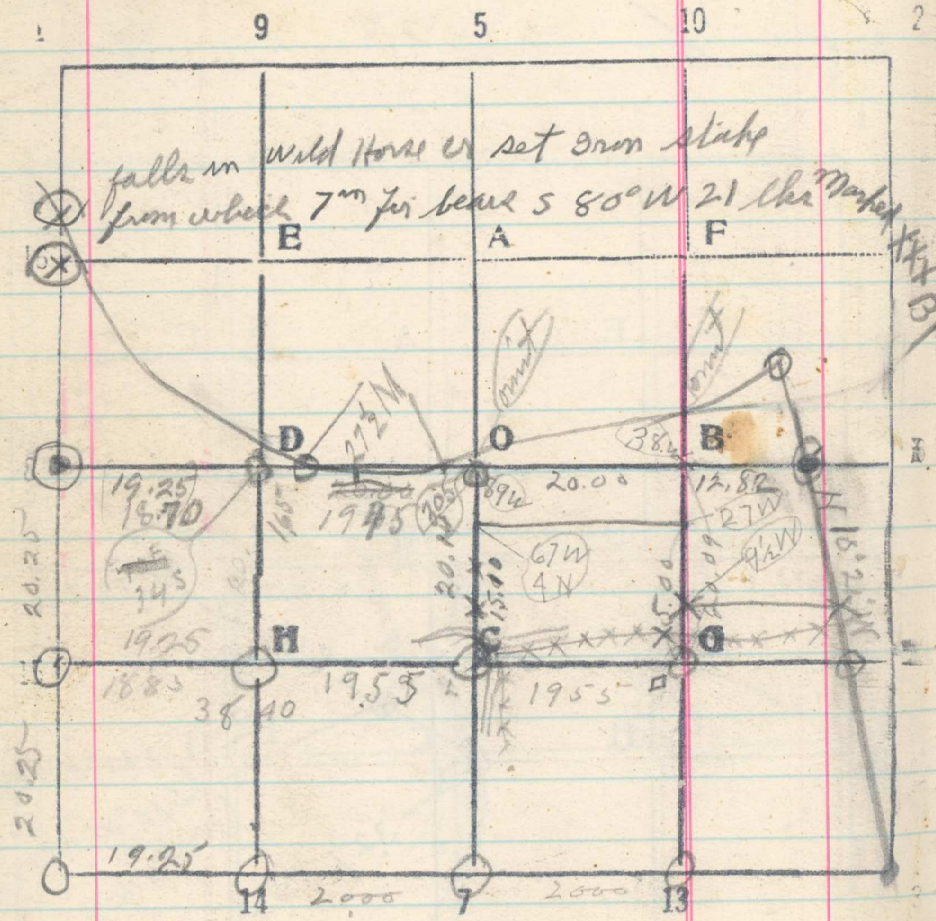

1906

80
287
59
426

462

80
383
59
522

399

39.25
37.85
1.40

17.85
.70
18.55
19.25
.70
19.60
84
18.76

.70
84
15 9

B 38 W
O 89 W

Line O, I
1949 Cor B bears 82 lks S.
from Cor B I turn an angle of 2°15' South
from line O.B. + fall 14 lks N of Iron Post
Line B - East to Boundary
12 14 chs Cor bears 14 lks S

From O - S. 18 I run West
143 mark 2m stump on E side of Wild Horse Cr
190 chs cross Creek thence along North side of Cr
2000 chs on Wild Horse Cr thence cross to South side
2089 chs set Stake
37.85 chs Cor S bears 47 1/2 S South