25

Sec. 20 T. 3 N. R. 36 E

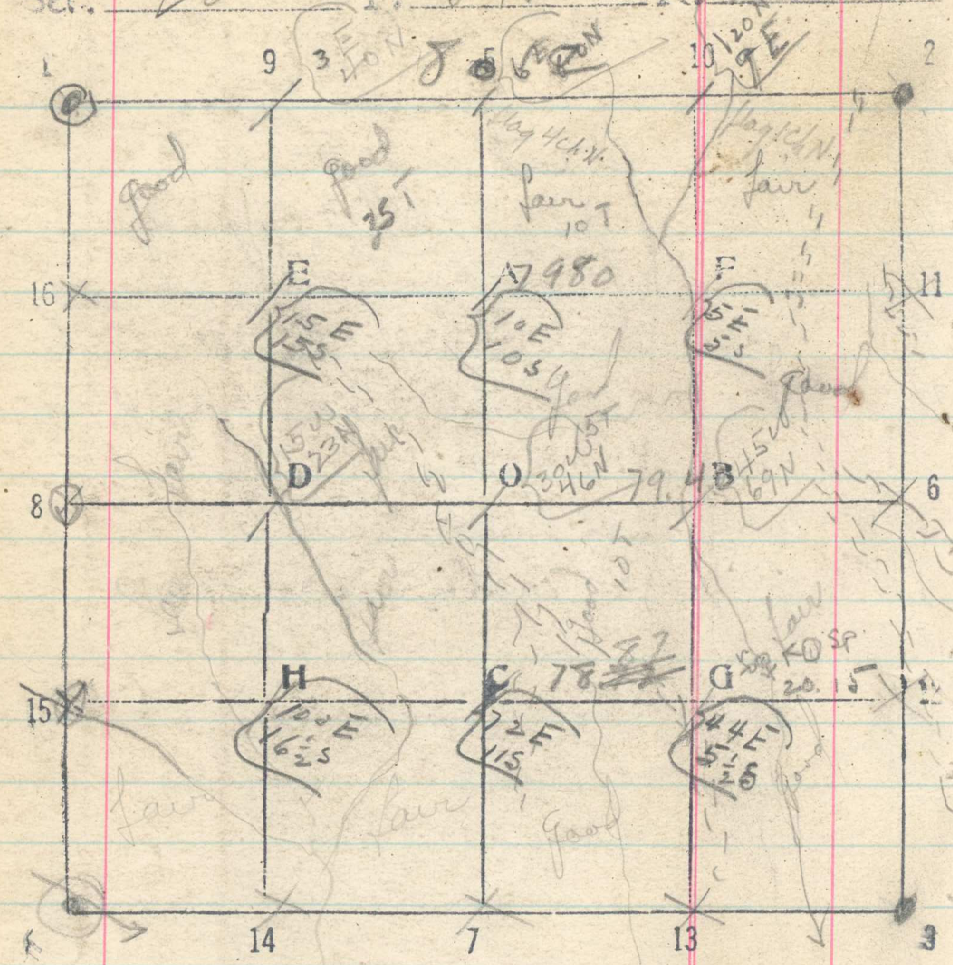

7/24 Line 1 – 2 East between 17 & 20

Set 20 – 40 – 60 (No sign of Type)

38 Begin descent

50 Ravine Hds. S 10 E. 63 Ravine Hds. S 10 W.

7650 Ridge N – S.

80.12 Sec cor. 16 – 17 – 20 – 21 bears N 160 lks.

7/24 Line 11 – 16 West Thru N half

Set 20 – 40 – 60.

10 Ridge N 10 E – 5 (rock. Base of Δ)

20.50 Ravine Hds. South

7980 1/16 Cor. 16 bears S 20 lks.

7/25 Line 8 – 6. East thru Center.

Set 20 – 40 – 60

Ravines 8 – S. 30 E. 20.50 S. 30 E.

79.40 1/4 Cor 6 bears N 9 lks

7/25 Line 12 – 15 West thru South half

Set 20 – 40 – 60

Ravines 12 – S. 30 – S. 45 – S 10 W.

78.[illegible] 1/16 Cor. 15 bears S 23 lks