5-177 Surveyed from N & S. 3-35
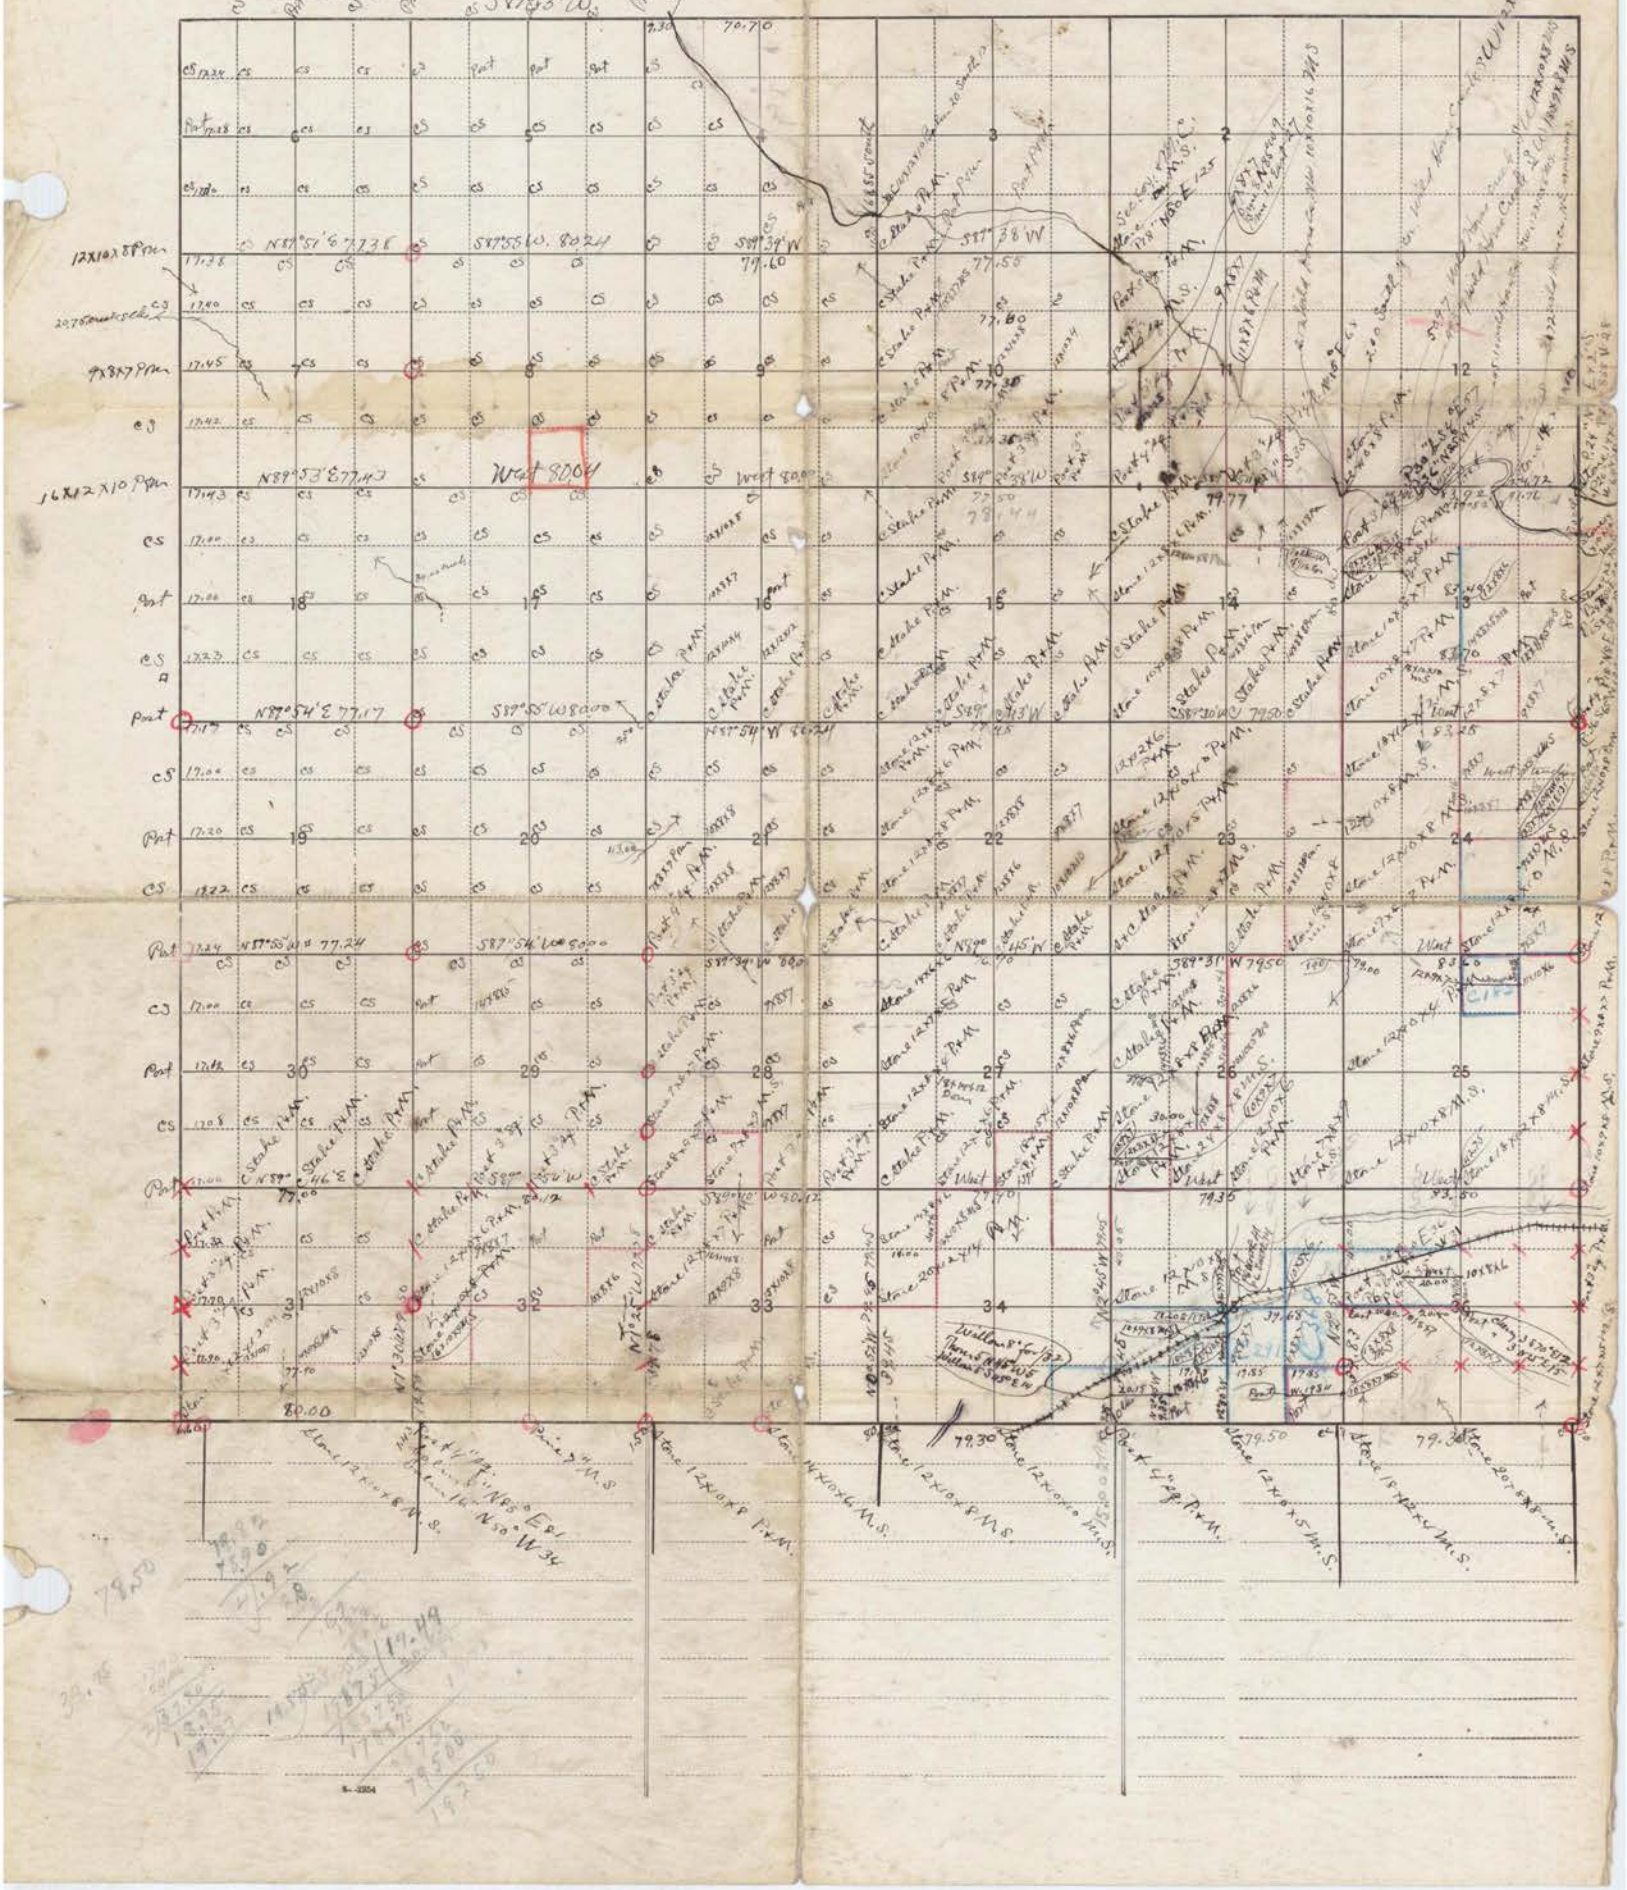
Township No. 3N Range No. 3E Meridian in