


Township No. 7390

Range No. 33

Meridian in

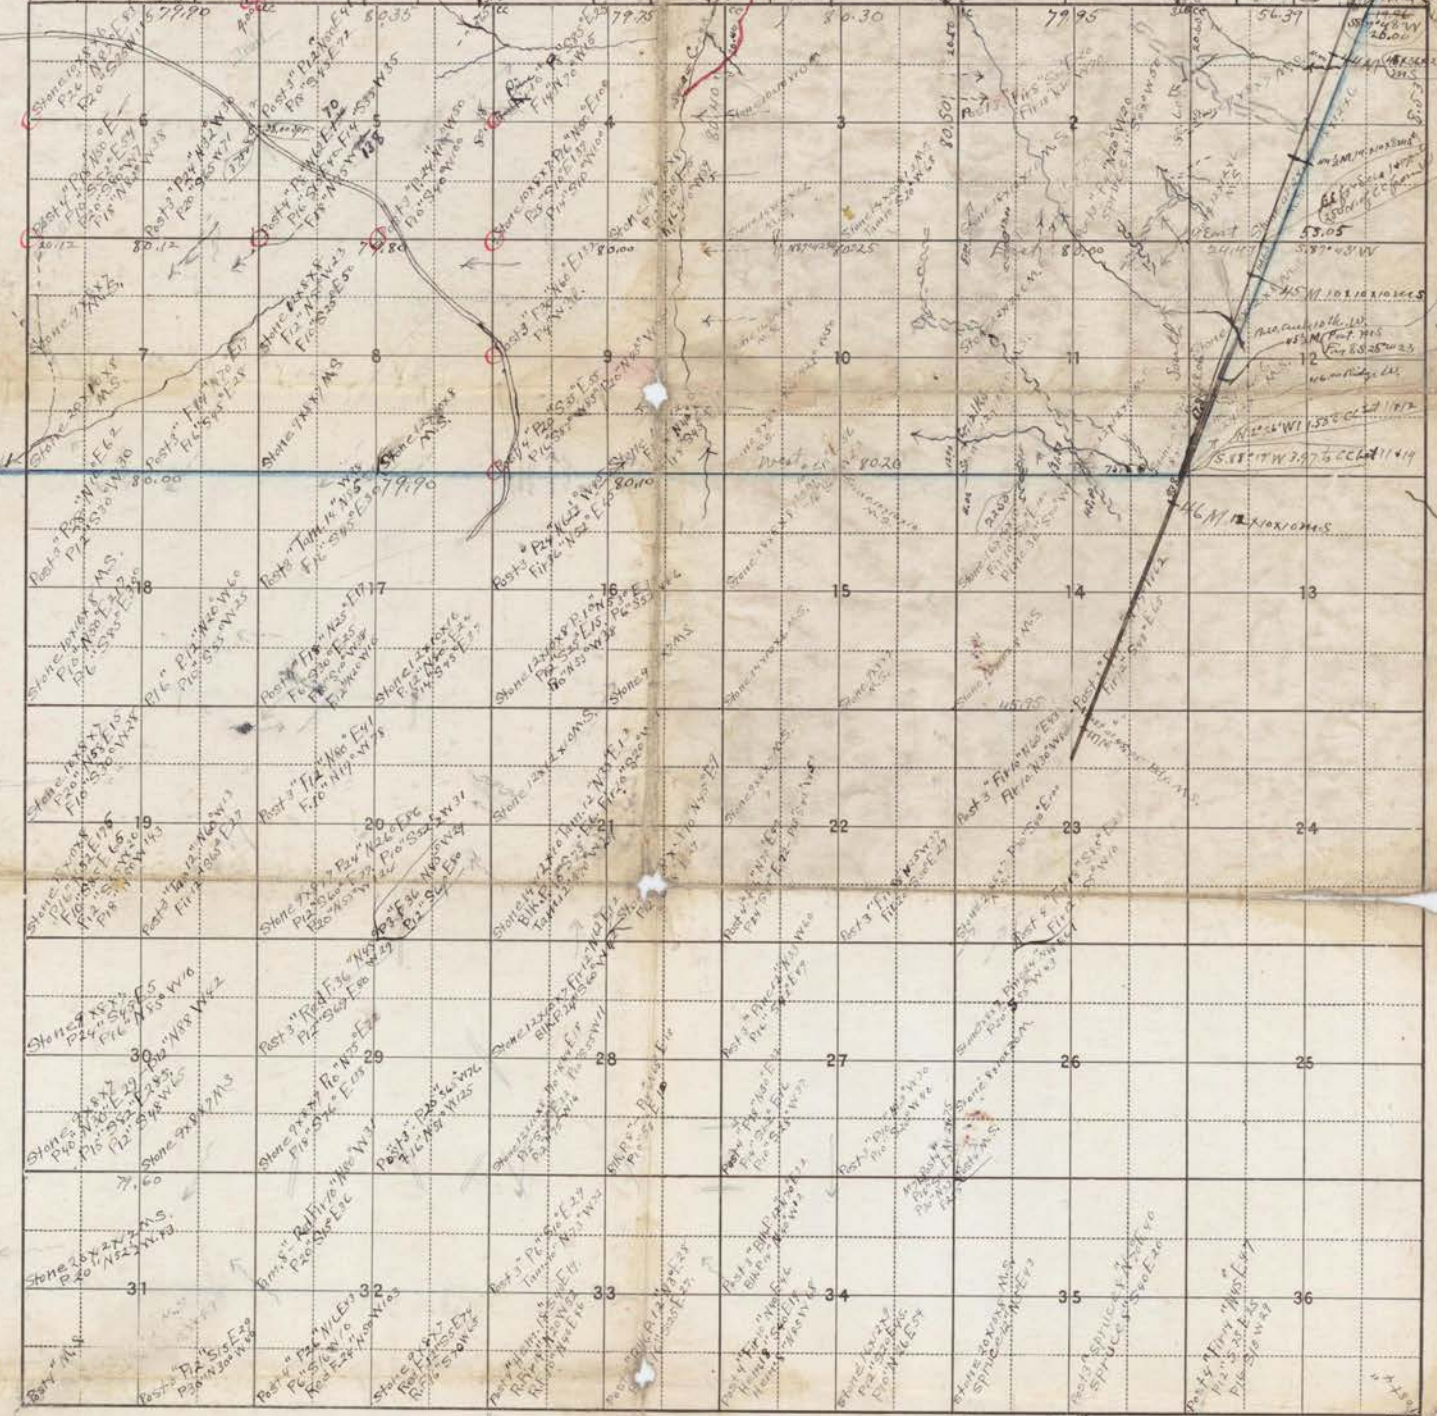

The corners on north boundary  
 are found by continuing the survey  
 straight up north. But it is different  
 from corners given on line surveyed  
 between twop. 14 & 20 that survey is  
 on another page.

78150

Handwritten notes in the bottom right corner, including the number 78150 and some illegible text.