

TIN R35E
 T1S R35E


SCRIBING OF
 BEARING TREES

JULY 1976

LTP

K.V.

T.W.

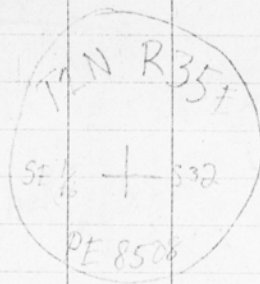


Ponderosa Pine → ET S38W

27.3

M. E. S

← S47E

Ponderosa Pine 58.6

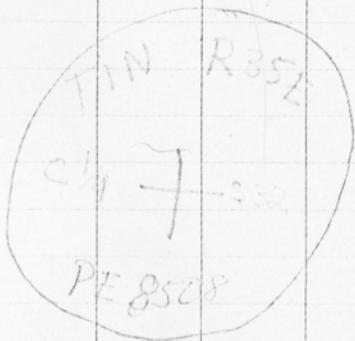

WHITE 4" DIA
 FIR

N55W

