


25.

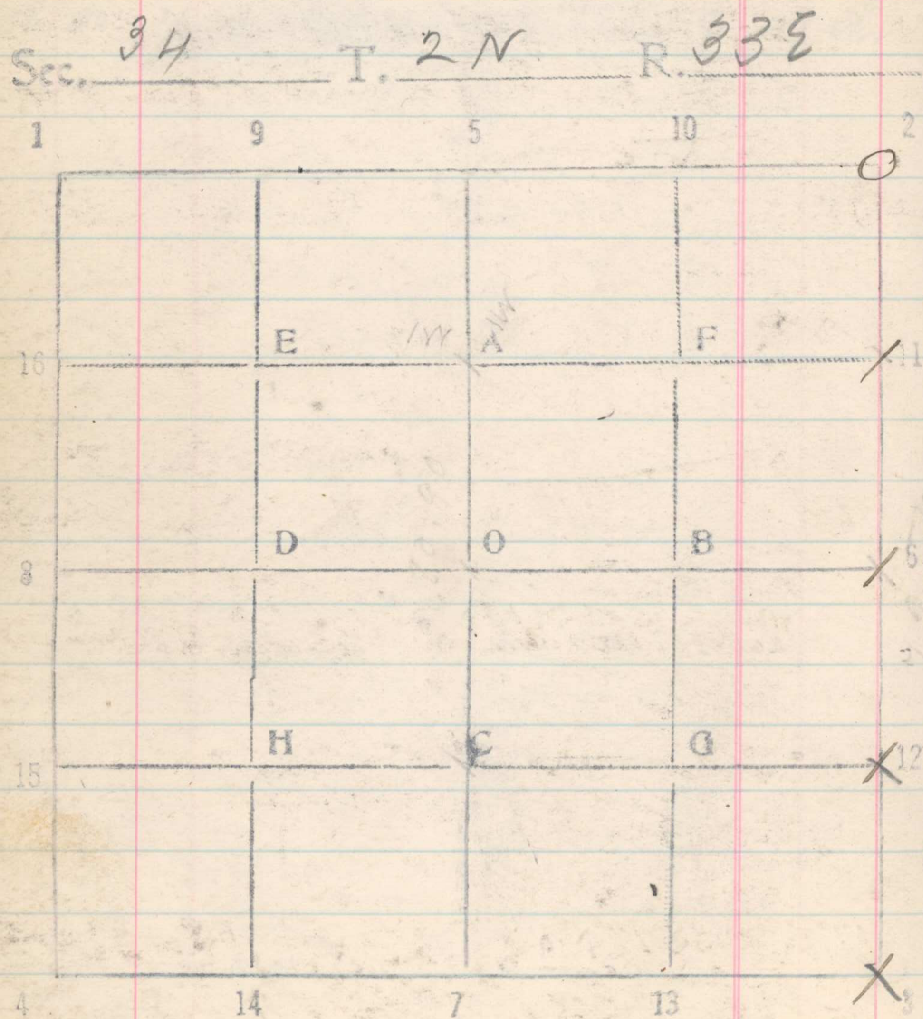

- Jan 2. 1918 From cor of 14, 15, 22 & 23, a stone properly marked, in center lane E & W road N+S, run South.
40. Not sure, set stake about 20 lbs E of fence in field
40.14 on line with fence to west
- 60.44 on line with fence to east
- 80 Set stake in field E of road, 10' transfer 22, 23, 26 & 27
- 80.75 Center of lane, ^{E+W} about 75 lbs E of center of N+S lane.
- 121.08 Fence, E+W, about 75 lbs E of center of N+S road
- 160.82 A MA Stone that appears to be remain of cor of secs. 26, 27, 34 & 35, in center of lane, E & W, + 50 lbs. E of fence on W side of road running N. About 75 lbs. West of creek channel, runs N. + crosses sec line about 250 lbs N of corner N+W.
- Thence South through field
- 39.97 A large post in E+W fence
- 40 Set stake
80. Set stake
- 80.14 temp cor of 2, 3, 34 & 35 set from West bears West 22 lbs.