33

2/76.77 76.77 .6 460.62 N 45° E 90 N 64 E 64
38.38 N 41° E 90 N 68 E 59
1.62 4S 5E
76.77 | 456000 | .059 2/4.56 1.62 .6 76.77 .19 76.63
38385 2.28 .10 9.72 76.58 76.50
72160 2/2.38 1.19 2.38N-2=2.36N .13
69093 1.16N 2N 33E

Sec. 6 T. 2N R. 33 E

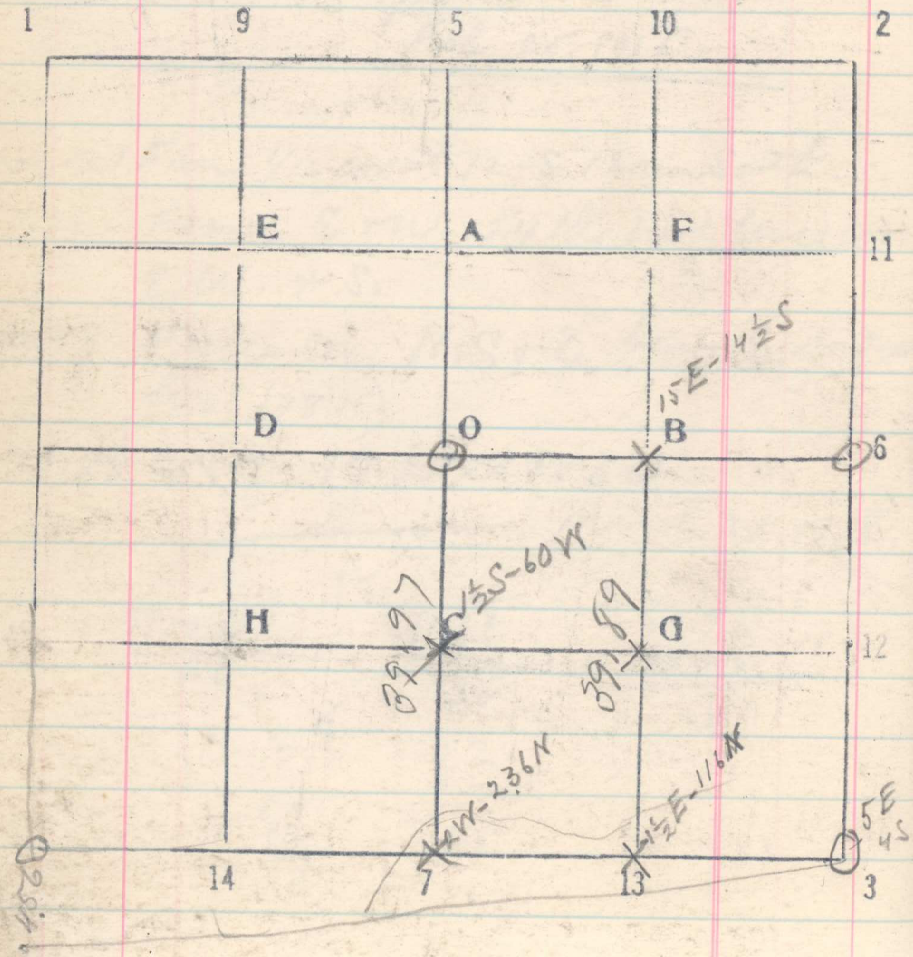

Feb. 26 Locate point for cor. of secs 5.6.7 & 8 by measuring N 45° E 90 lks from stump of old Bearing tree in Sec 7, a cottonwood 32 ins, marked S 7 BT other marks obliterated. Set a stake at this point, which falls on gravel bar in Umatilla River, N W.

Thence west bet secs. 6 & 7 through timber & brush,

20 Set 1/16 cor

40. Set 1/4 cor

76.77 − .19 76.58 + .05 76.63 (76.50) Cor C of secs 6 & 7 bears N 4° E. 4.56 ch

From 1/4 cor bet secs 6 & 7 run North 4° to right of rt Angle from E & W random.

20 Set 1/16 cor.

39.97 1/4 cor at center sec. 6 bears W. 120 lks

Thence East

20. Set 1/16 cor.

40.30 1/4 cor bet Secs 5 & 6 bears S, 29 lks.

Feb. 26. 1918

From 1/16 cor 20 chs W of cor of 5.6.7 & 8 run North

20 Set 1/16 cor

39.80 1/16 cor bears W. 11 lks.

Feb. 27. 1917