41

3½
1½

6
79.36
31
79.67
79.99
159.66

80.02
79.70
159.72

80.30
79.36
159.66

Sec. 11 T. 2N R. 33E

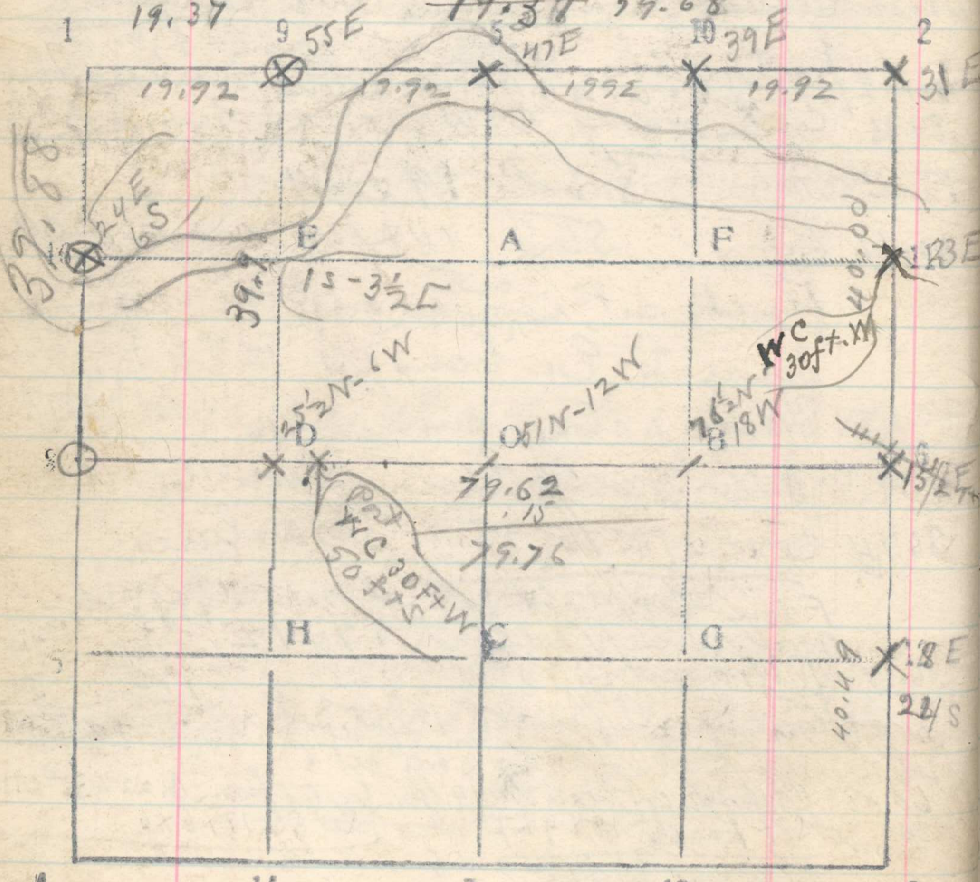

15
11
9

From 1/4 cor bet 10 + 11 run N
RR
10.45 Umatilla Rivers, N70°W soon turn N for
16.73 15 ch. Post in fence. Base West 50 lk
1.69 Angle N16°30'E. Dist. 1.69 ch.
18.42 Waters edge N of river
20 Set
39.88 cor of 2.3.10 + 11 bears E. 48 lks,

From 1/4 cor bet 10 + 11 run S89°E from
B.S. on random to N.
20 Set Stone 18 X 6 X 6
24 Set Stone 12 X 8 X 7 marked (X) U1 S on S W
Set iron post 30 ft. W, and 50 ft S for WC
39.88 On line with fence to S
~~40~~ Set stone On line with
fence to N.

60 Set
79.76
~~79.61~~ Stake at 1/4 cor bears N. 110 lks.
From temp cor of 1.2.11 + 12, which is 31 lks W of true
cor. pt. run
West bet 2 + 11
20 Set stone 12 X 10 X 5 for 1/16 cor. Fence N + S (on W side of lane)
40 Set stone 24 X 7 X 6 M S. on bar in river
60 Set Iron post
~~79.36~~ Intersect cor of 2.3.10 + 11
79.68