Oct. 2 From cor of Secs 4.5.8 & 9 run West
20 Set 1/16 cor
30.40 Ow R & N Ry. N 70° E
40 No trace Set 1/4 cor
60 Nature of ground as bottom and brush
79.60 Cor of 5, 6, 7 & 8, a stone pit & mound in MS, bears S. 36 lks.

From 14-S-5 run North
5.00 Umatilla River N 70° W
10. Set 1/64 cor.

From 1/4 cor bet 5 & 8 run North
10. Set 1/64 cor
10.75 Umatilla River. S W
15.00 Set stake. Oct. 12. 1915
20 Set stake
41 Set flag at O.
76.06 1/4 cor on N bdy sec 5 bears W. 86 lks

From O-S.5 run East
20 Set A-S.5 Oct. 12. 1915
39.96 1/4 cor bears N. 28 lk.

From B-S. 5 run S. by E 5 to 10-S.5
20 Set 1/16
20.06 13-S.5 bears W. 18 lks. Thence more
B-S.5 10 lks. W. Oct 15, 1915
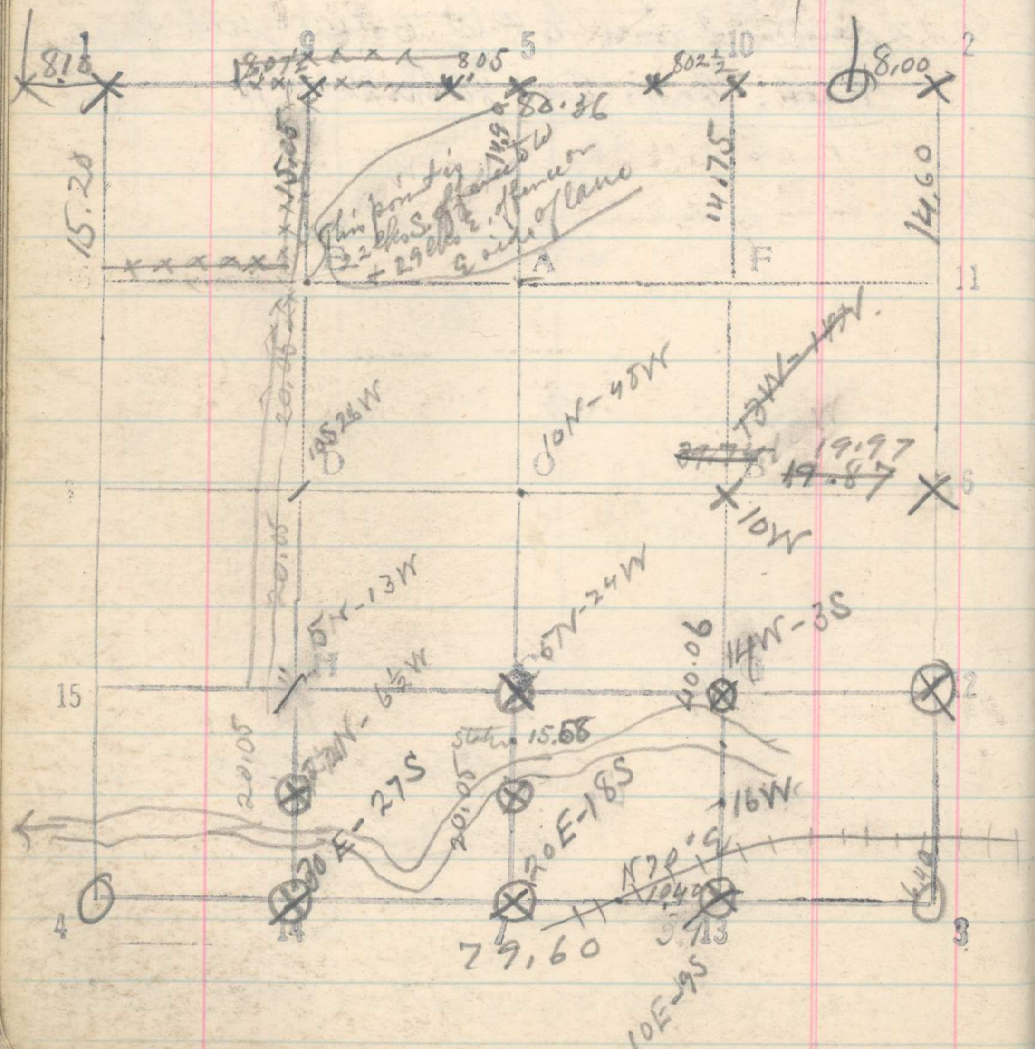
Sec. 6 T. 2 N R. 34 E.