


Sec. 13 T. 2N R. 34E

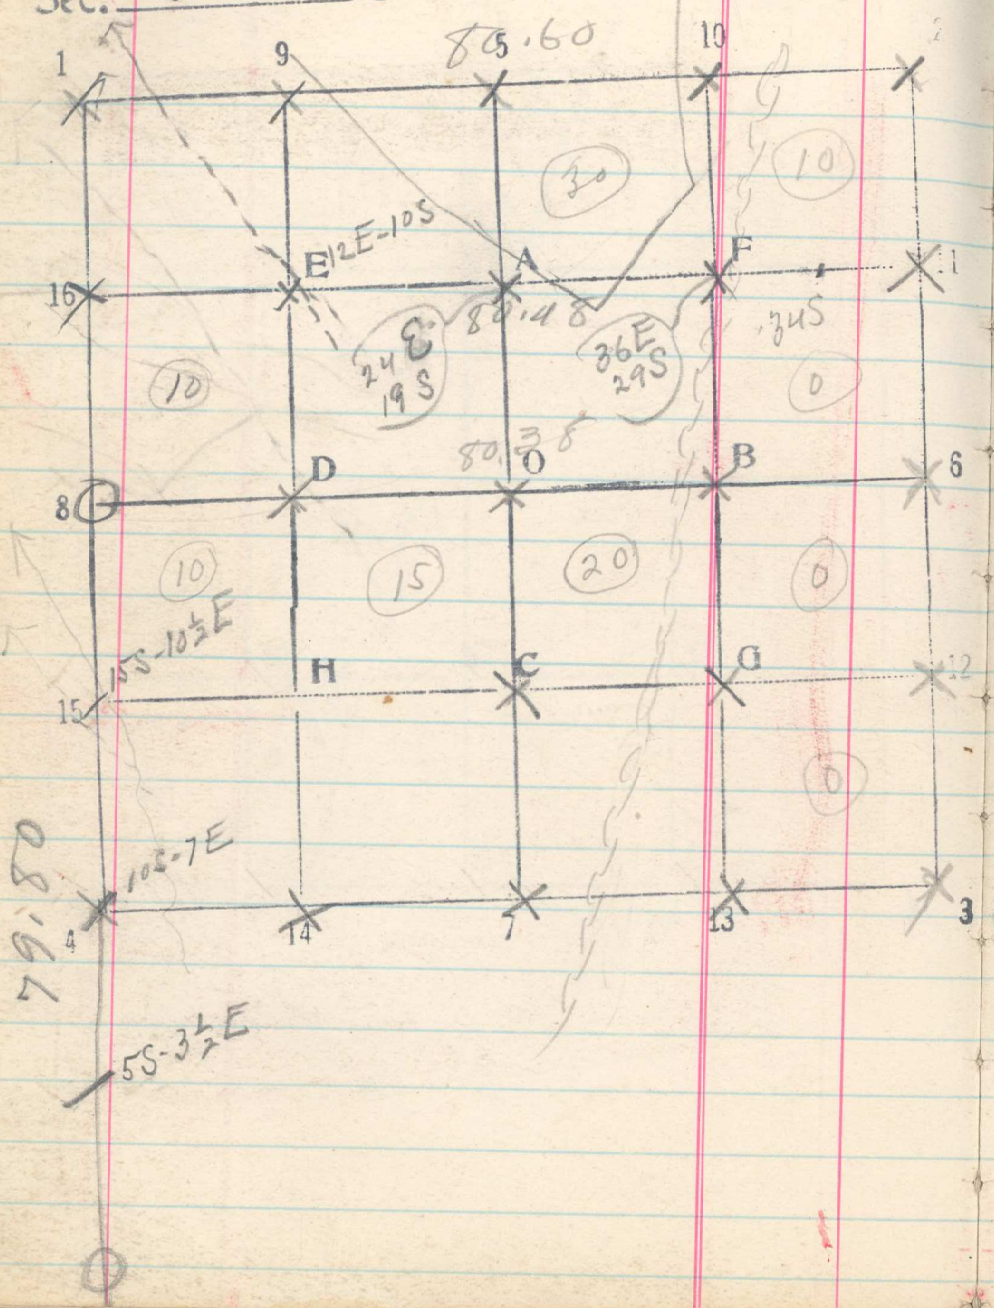

212