


Sec. 23 T. 2N R. 94E

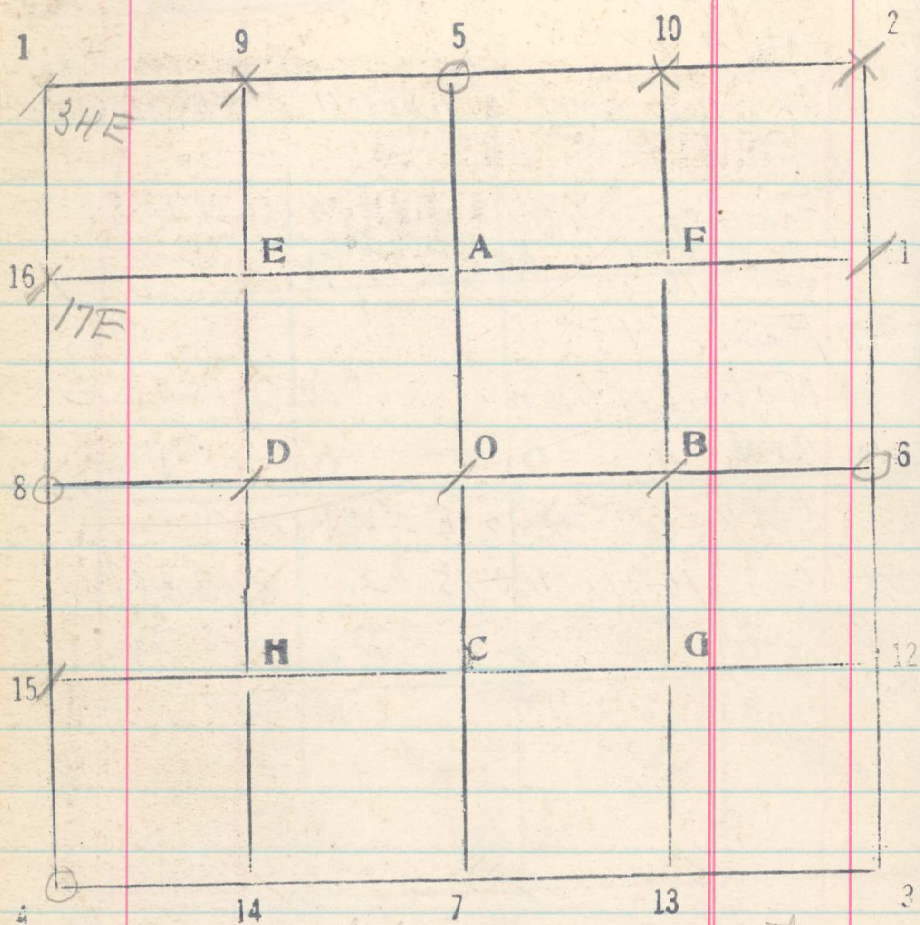

From 1/4 cor bet 22 & 23 run north  
Set  $\frac{1}{2}$   
no transfer of 14, 15; 22 & 23