Sec. 35 T. 2N R. 34E

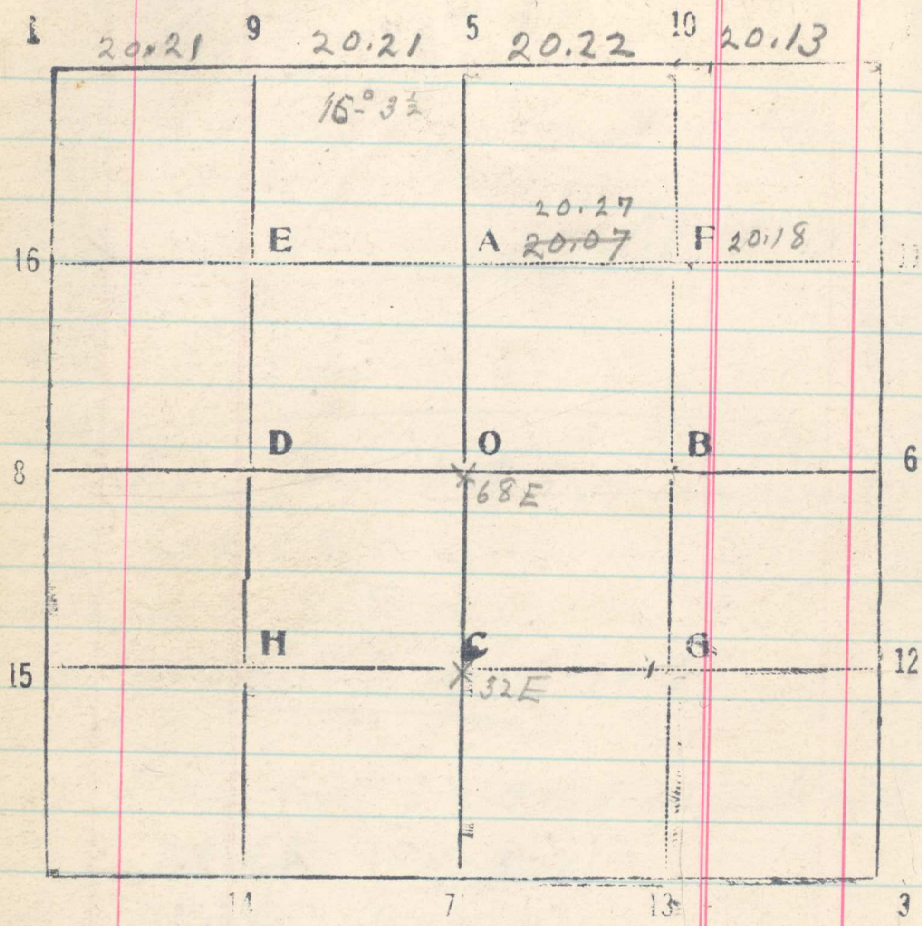

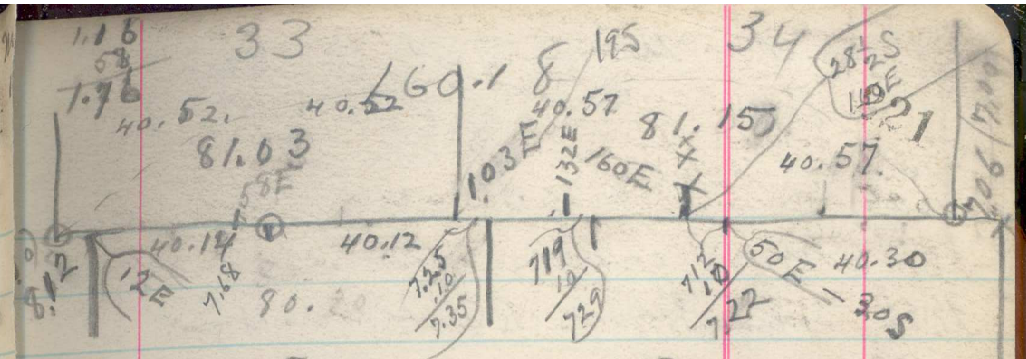

88.38
.0
88.30
8.26
.58
7.68
8.38
1.16
7.22
7.19
6.62
.57

7.68
.46
8.14

5
48.26

7.25
2.16
1.76
.40

8.38
7.35
1.03
8.38
7.35
1.03E
2.18

88.38
1.16
88.22
48.26
8.38
1.76
6.62
7.19
.57

1.75
1.03
.72
3 1.14
.57
1.71

1.03
.57
1.60
1
8.38
1.76
6.62
7.06
42.18
49.24
8.38
40.86
40.19
.67E

4
42.18
1.75
40.43 +
7.06
47.49
7.19
40.30
7.19
10
7.29

19+9½=28½
1½
30N

42.18
1.60
40.57

2)57
28½E
103
131½

8.38
1.32
7.06
7.29
.23E