


$$\begin{array}{r} 60 \\ 152 \\ \hline 4 \overline{) 212} \\ \underline{53} \\ 159 \end{array}$$

$$\begin{array}{r} 62 \\ 7 \\ 59 \\ \hline 253 \\ \underline{53} \\ 100 \end{array}$$

$$\begin{array}{r} 40. \\ 80.70 \\ 40.30 \\ \hline 161.00 \end{array}$$

Sec. 16 T. 2 R. 34

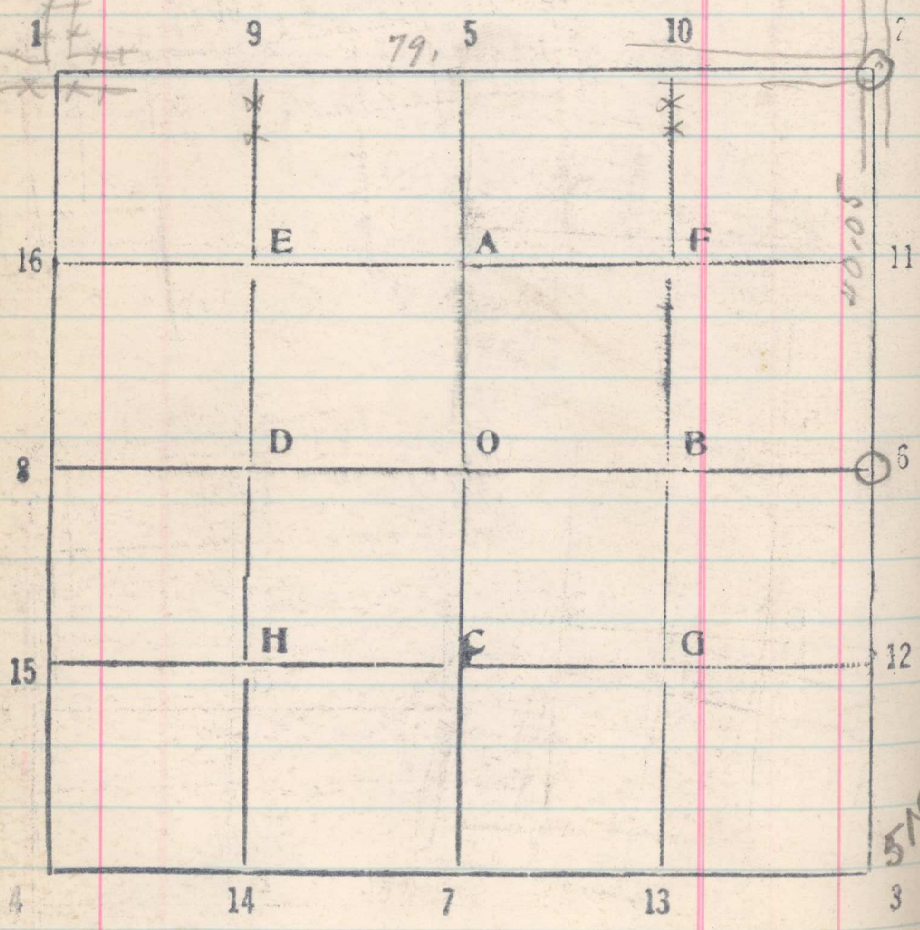

Sect. 16  
 From corner of 16, 17, 20 & 21 am N  
 20.09 Fence, E SW, No trace of 1/16 cor  
~~80.00~~ No trace  
 60. No trace  
 80.43 center of main road,  $\frac{1}{16}$  cor  
 on line with center of lane running N,  
 bears East. 45 lbs.  
 there East in road  
 19.97 on line with fence running S, No trace  
 40. No trace  
 59.79 Olive with fence running S.  
 60 No trace  
 79. Cor of 14, 15, 2 & 23, a stone, in road,  
 on line with fence to E, & center  
 land to N,  
 there South in lane  
 40.15  $\frac{1}{16}$  cor, a stone, in road.