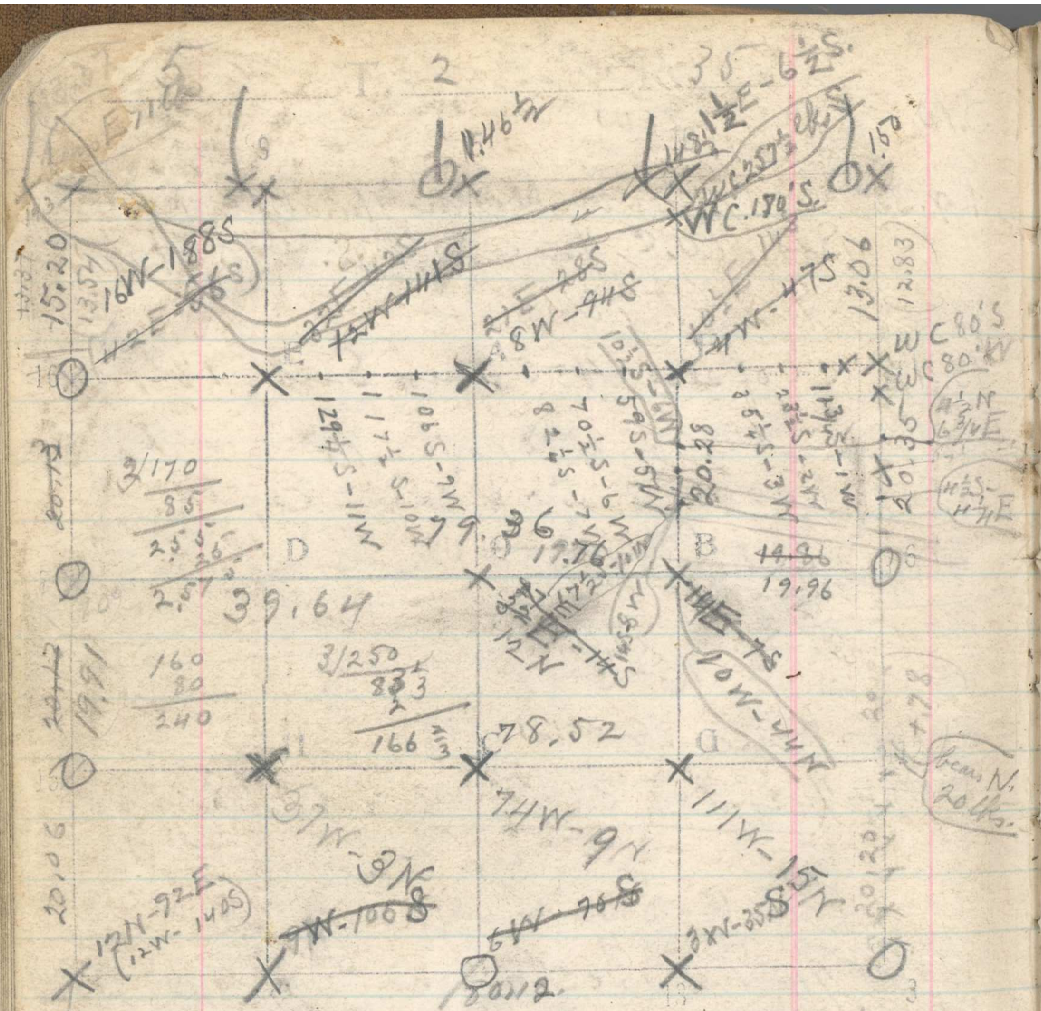
T. 2
5
9
16
21
20
20.06
