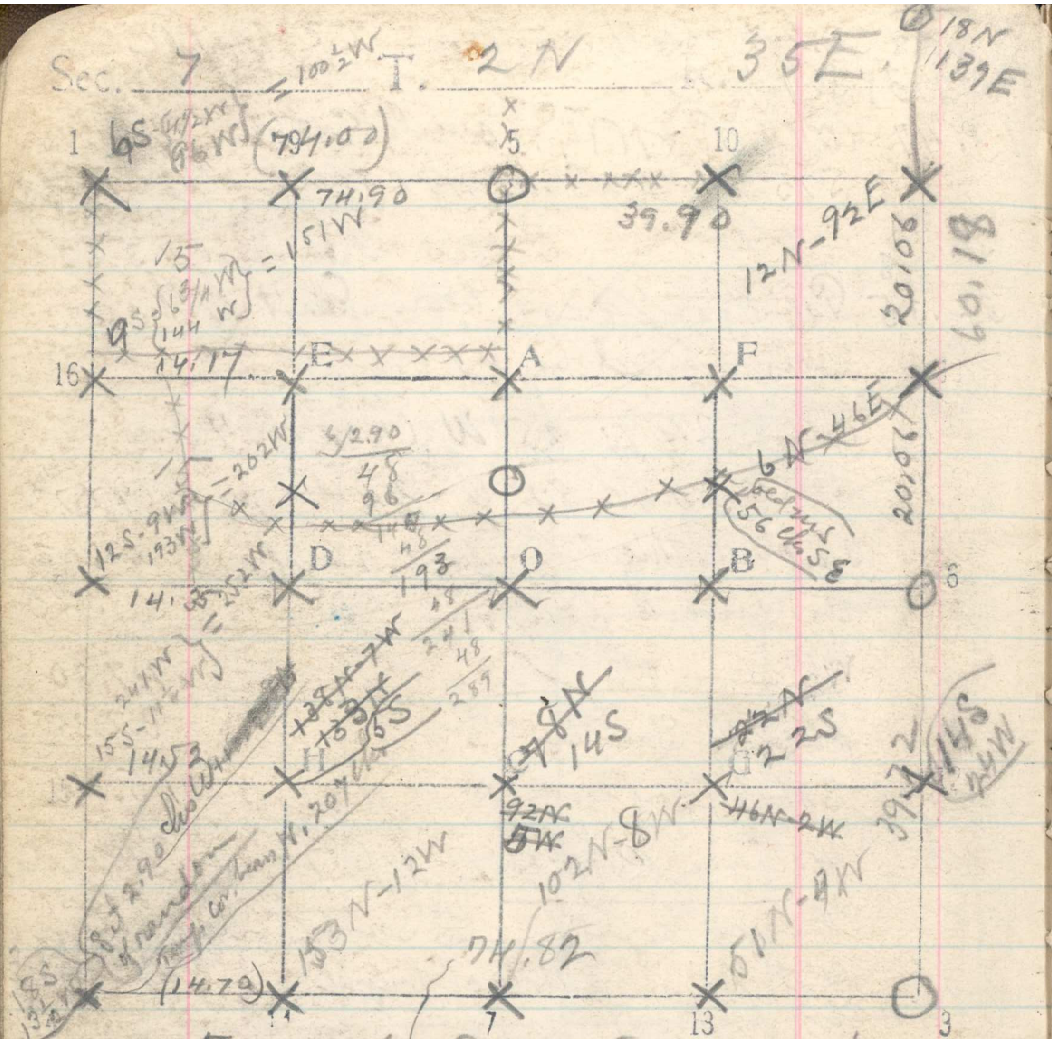

Aug. 7 From cor of 7.8.17 & 18 sections West
20 Set 1/16 cor.
40 No trace Set 1/4 cor.
47. Buckaroo Canyon. N 20° E.
60 Set 1/16 cor.
74.70 No trace of cor of 7, 12, 13 & 18. Set stake
74.82 Temp cor of 7, 12, 13 & 18 bears N. 20 E 1.90 lks.
Cor bears North 1.90 lks.

From cor of 7.8.17 & 18 sections North
20. Set 1/16 cor
24.50 Creek. East. Buckaroo Canyon
39.72 1/4 cor, a stone in md. Scribed 4 S
Thence North by B.S. on cor. 3,
20 Set 1/16 cor.
40. No trace of cor of 5, 6, 7 & 8.
60.15 Fence cor bears East 1.39 lks.
60.15 1/16 cor at 12-S. 6 bears East 1.39 lks
80 Set 1/4 cor Fence cor bears E. 6.7 lks, which I accept
80.20 as 1/4 cor, as Stone may City surveyor set at this point.
100 Set 1/16 cor
102.05 offset 112 lks East N & S random
13.37 13.37 chs. S. of C.C.
Thence N 0° 30' W 13.37 to pt. 71 lks W of C.C. (N 13.37 - W - 11 lks.)
Hence (71 - 11 = 60) 112 + 60 = 172 lks E
115.42 C.C to secs 5 & 6 bears E 1.72 lks.

July 24, 1911
(3 1/3 ft high. Scribed
From 11-S. 6, a post with nail in top, bears S 133 lks & West 58 lks. Jim Hall says the post in 1/16 cor set by City surveyor. I accept it as 1/16 cor.