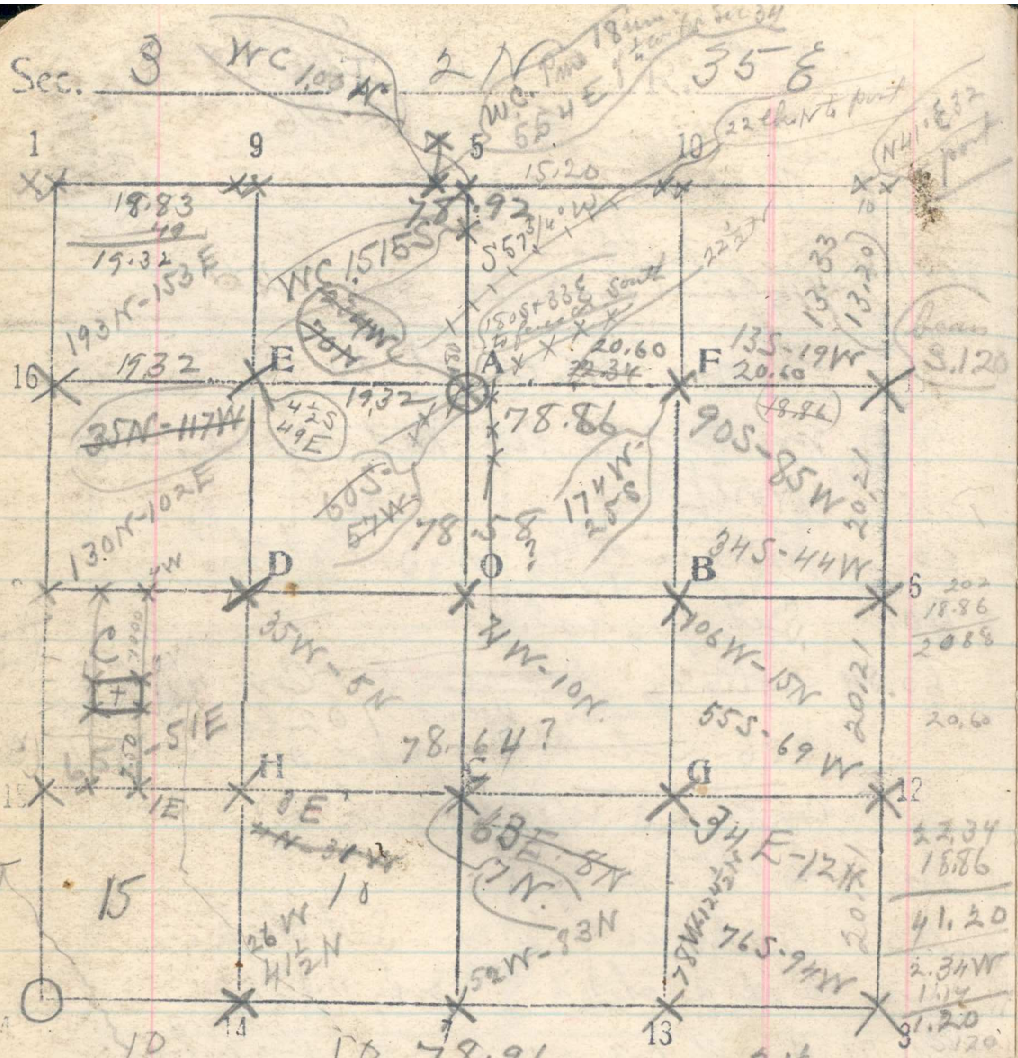

S 5.00 - East 2.33 = (3.50)

1.17

from end of base Cor 3 - S. 3 bears N 10 E

Dist 15.54 + 3.50 + 61.17 = 3.1084

Cor 3. 4. 9 + 16 bears N. 166 lks

Set 1/4 cor for Sec 34, on N bdy Sec 3,
on bank in Umatilla River
and set W.C. 100 lks N. Pine 18 for W.C.
Set 1/4 cor for Sec. 3, 45 lks E.
of 1/4 cor for Sec. 34, and set W.C.
1.51 1/2 lks. or 100 ft. S., on Said
river.

From 15-S. 3 mm East

5.00 Set stake
10 Set stake
20
38.64 Set 1/16 C - S. 3 bears N. 30 lks.
58.64 Temp C - S. 3 bears N. 7 lks.
Temp G - S. 3 bears N. 7 lks.

78.86
41.20
2)37.66
18.83

4)78.64
19.66

7886
4)78.58
19.64
7856