


Sec. 18 T. 2 N 35 E

(See Sec 7)

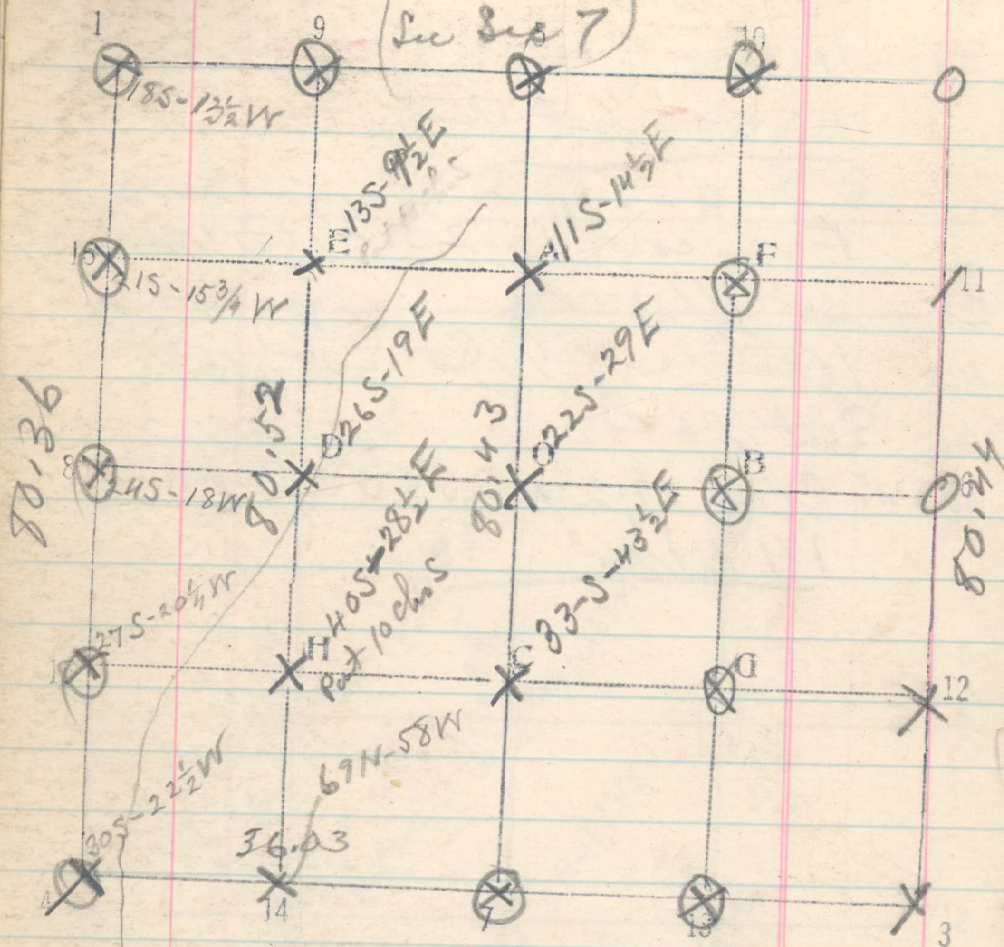

From top cor of 7, 12, 13 & 18 run S

- 20 Set 1/16
- 40 No trace of 1/4 cor set stake
- 60 Set 1/16
- 80 Protrusion of cor of 13, 18, 19 & 24. Set stake