Sec. 5 2 T. 2N R. 34E

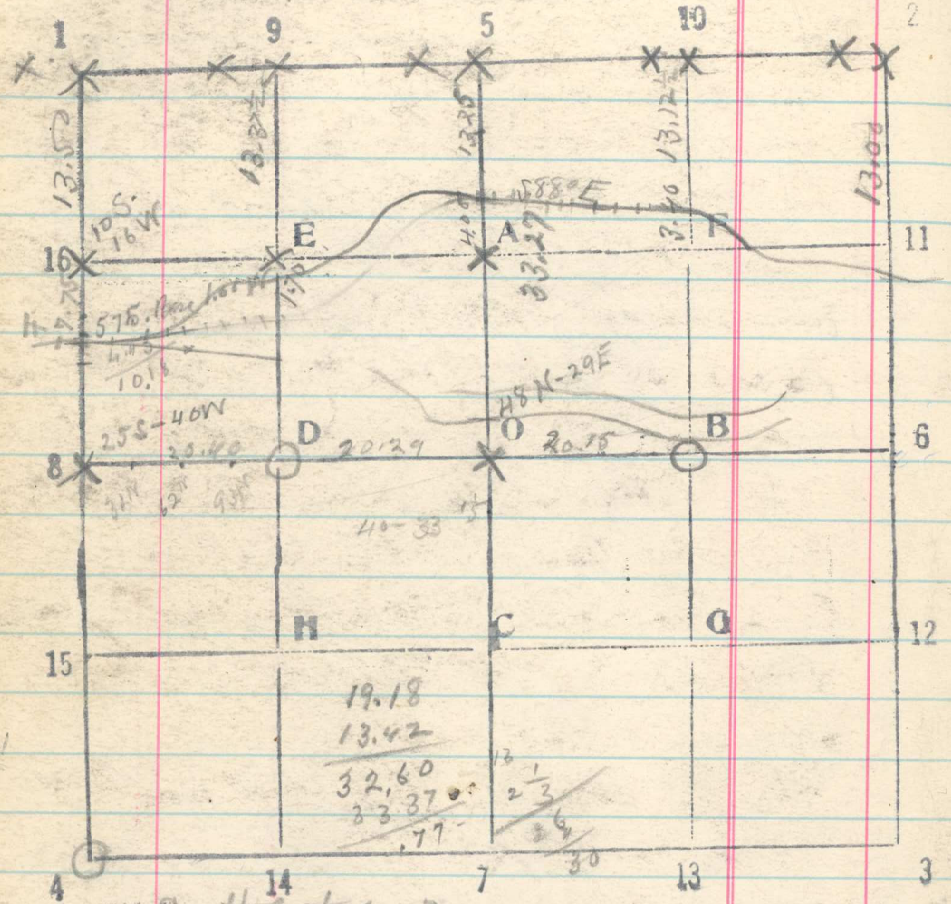

South bet 2 & 3

13.50 Set 1/16 cor.
20.32 RR. N 70° E Fence. E & W. 64 lks N
Set 1/4 cor.
53.50 Set stake in road
54 Fence to west
Center of N & S road. 67 lks wide 16 lks
W of my line
74.12 Pt. of cor. of 2.3.10 & 11 as identified by Sidelet Hawks & wife. On line. [illegible]

12 x 8 x 8 mkd (X) on top & S notches on S & 2 on E in road, N.S.&W. Oct 24 1918

197

The above corner is on line with fence South, 22½ lks (15 ft.) N. of fence to west on S. side of road, and 53 lks E. of N & S fence on E side of road, & 18 lks E of fence to N. on W side of road

From 1/4 cor bet Secs 2 & 3 run East 90° from random N & S line.

20.40 1/16 cor D-S.2, bears N. 124 lks. This cor is a stone 9 x 8 x 7 mkd 1/16 on W face from which Cottonwood or Balm 20 N 80 W 23 lks mkd 1/4 S. I cut this mark out, but not BT Cottonwood 20 S 13° W 46 lks marks partly obliterated. I cut into tree about 4 ins to uncover marks.

Thence East 40° to left of // with last 20 chs. random.

20.29 Fence. N & S.
Point for.
40.44 1/16 cor. at B-S.2 bears N. 96 lks.
I locate this cor at intersection of lines toward which the blazes on old BTs face, as the bearings and distances do not agree with field notes, except distance to N W tree, which [illegible]
These trees are Pine 24 N 83° E 60 lks. (N 2° W 30)
Pine 20 N 46° W 24. Marks on both trees partly obliterated (N 75° W)

This cor is described as: Pine 12 N 2° W 30 Pine 6 N 78° W 24 (20 ft S. of [illegible])