


Sec. 16 T. 2 R. 35

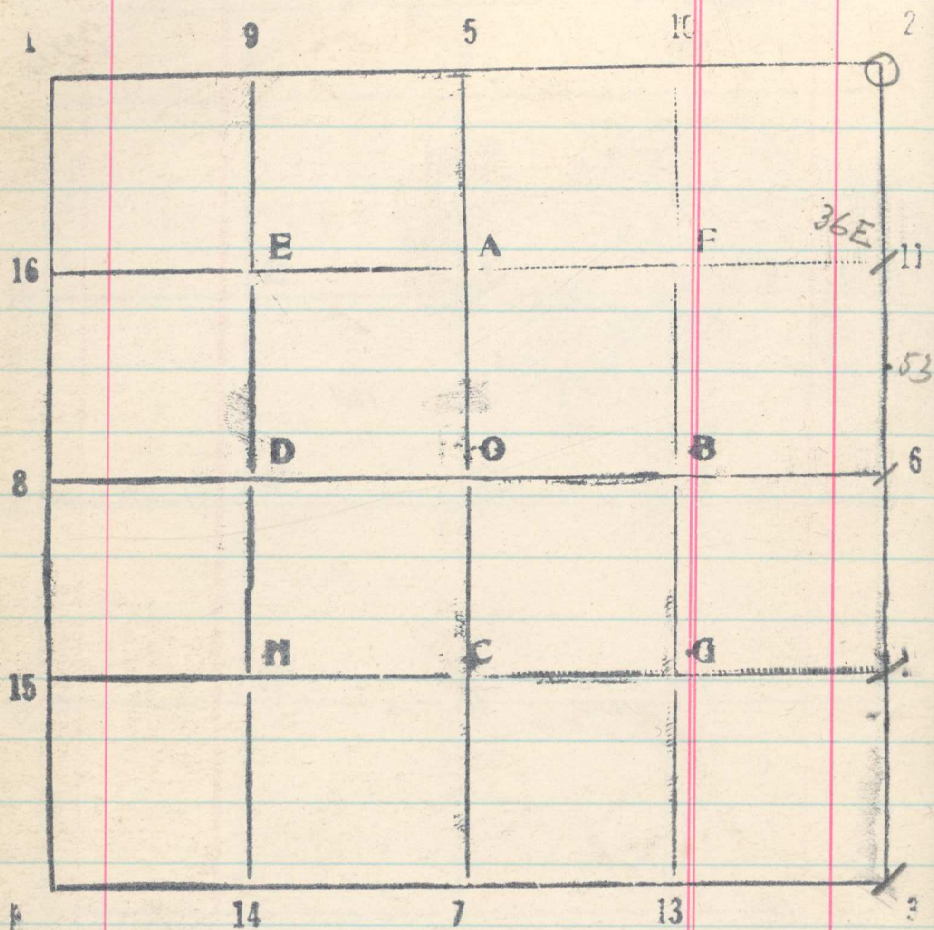

May 15, South bet. 15 & 16

20 Set 1/6

40 Set 1/4 cor.

60 Set 1/66