


Sec. 29 T. 3N R. 36E

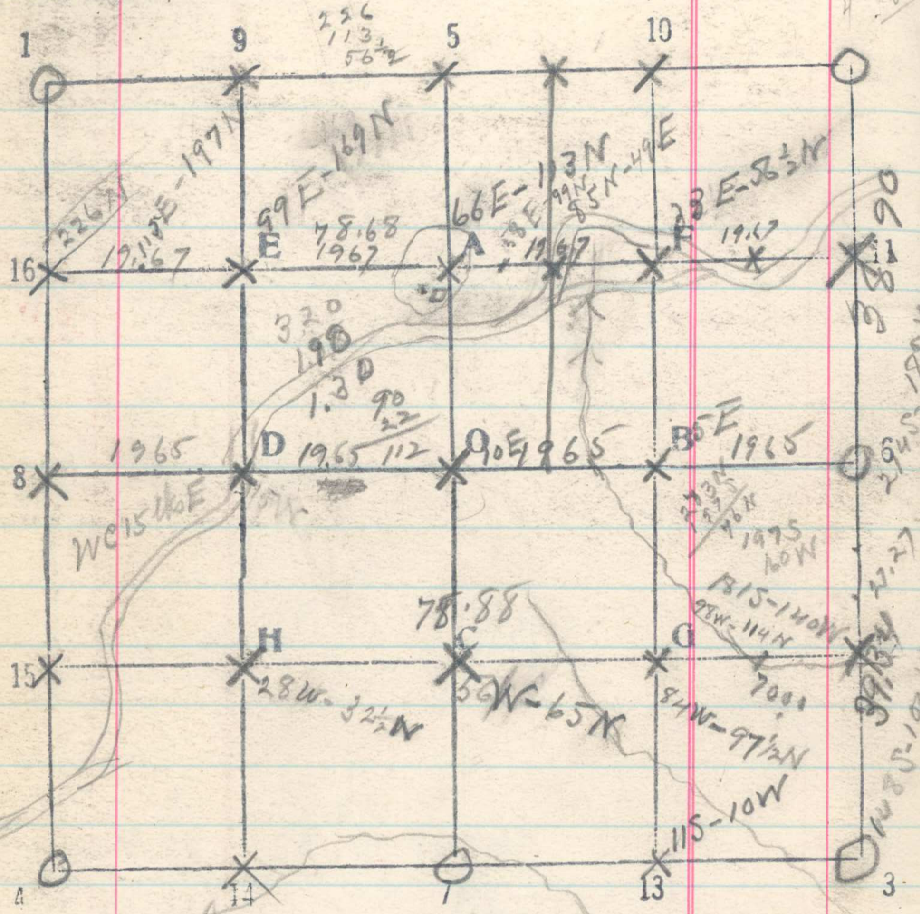

From 15-S. 29 m East

20 Set $\frac{1}{16}$
 40 Set $\frac{1}{16}$
 61 Set $\frac{1}{16}$
~~71~~ From 19 1/2 to left
 78.88 Cor 12-S. 29 bears N. 130 lks.

From cor 11-S. 29 run west

20 Set $\frac{1}{16}$
 30 Set $\frac{1}{16}$
 40 Set $\frac{1}{16}$
 60 Set $\frac{1}{16}$
 78.68 Cor 16-S. 29 bears N. 226 lks.

120
 1207
3140
 20

From 1/4 cor bet 28 & 29 run West

19.70 Set $\frac{1}{16}$ cor B-S. 29
 29.55 Set $\frac{1}{32}$ cor $\frac{0-13}{2}$ -S. 29
 39.40 Set $\frac{1}{4}$ cor O-S. 29
 19.40
 58.80 Set $\frac{1}{16}$ cor X-S. 29
 19.80
 78.60

Intersect $\frac{1}{4}$ cor bet 29 & 30, Dec 4, 1918