


6  
 Sec. 1 T. 1N R. 34E

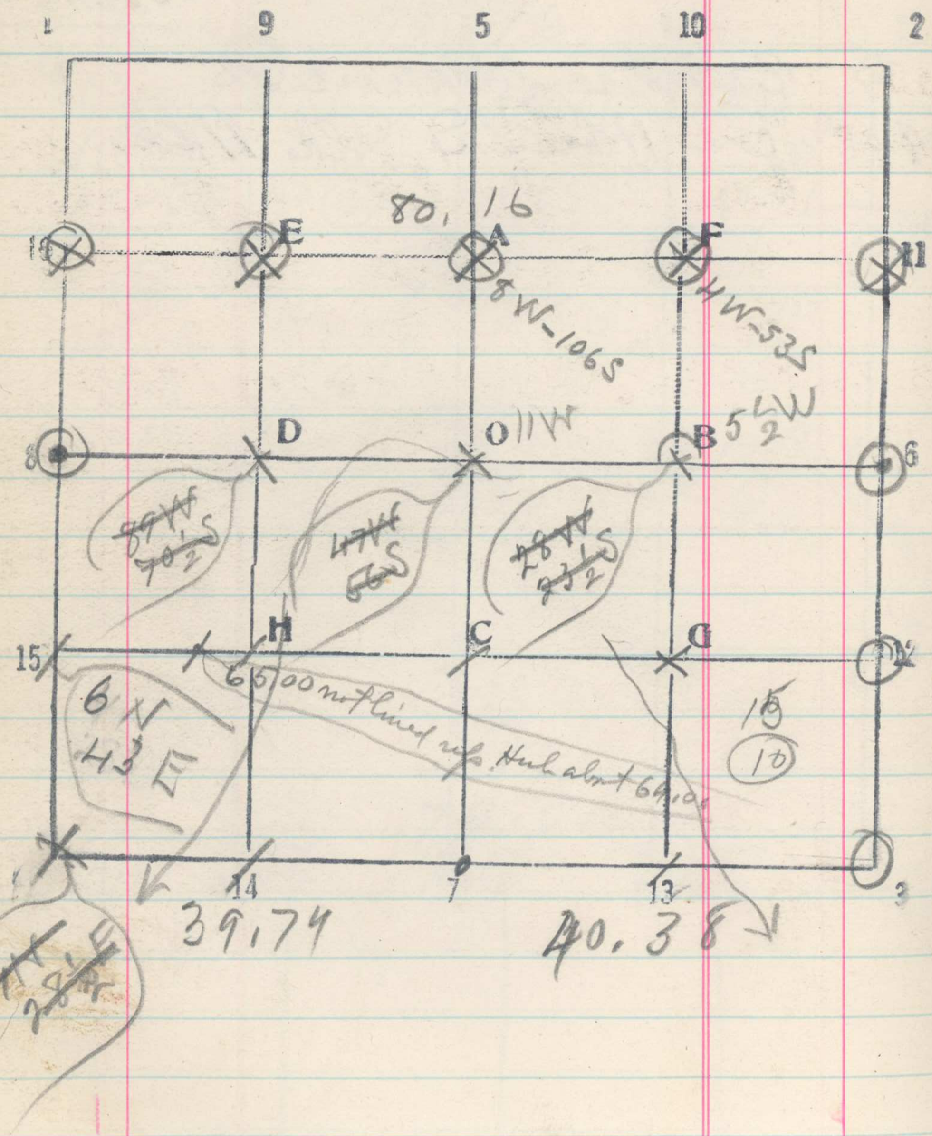

Line 6-8

20  
 40.22 Temp O set from post 2 years ago  
 bears S, 32 lks, Flag to W  
 on line to W bears S 89° 30' W  
 Hence  
 80.22 Distances 1/4 cor bet nos 1 & 2  
 Nov 20, 1919