


9

Sec. 10 T. 1N R. 34E

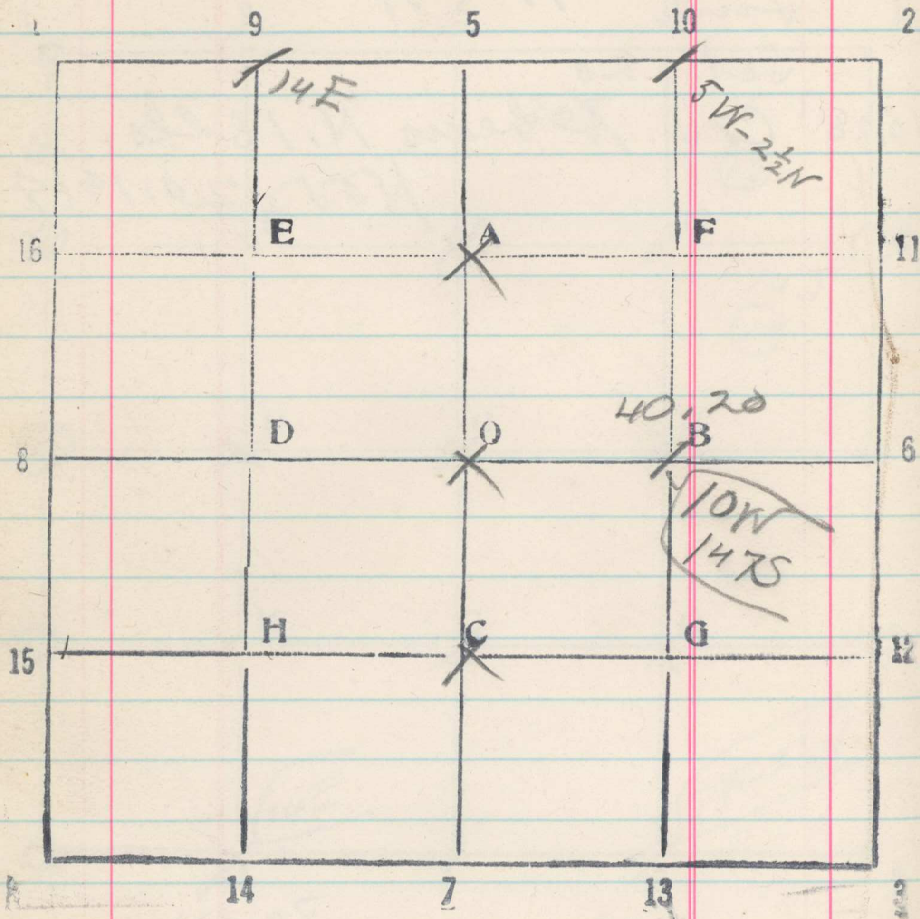

291