


Sec. 36 T. 24 R. 33E

Examiner Date 3/19 1918

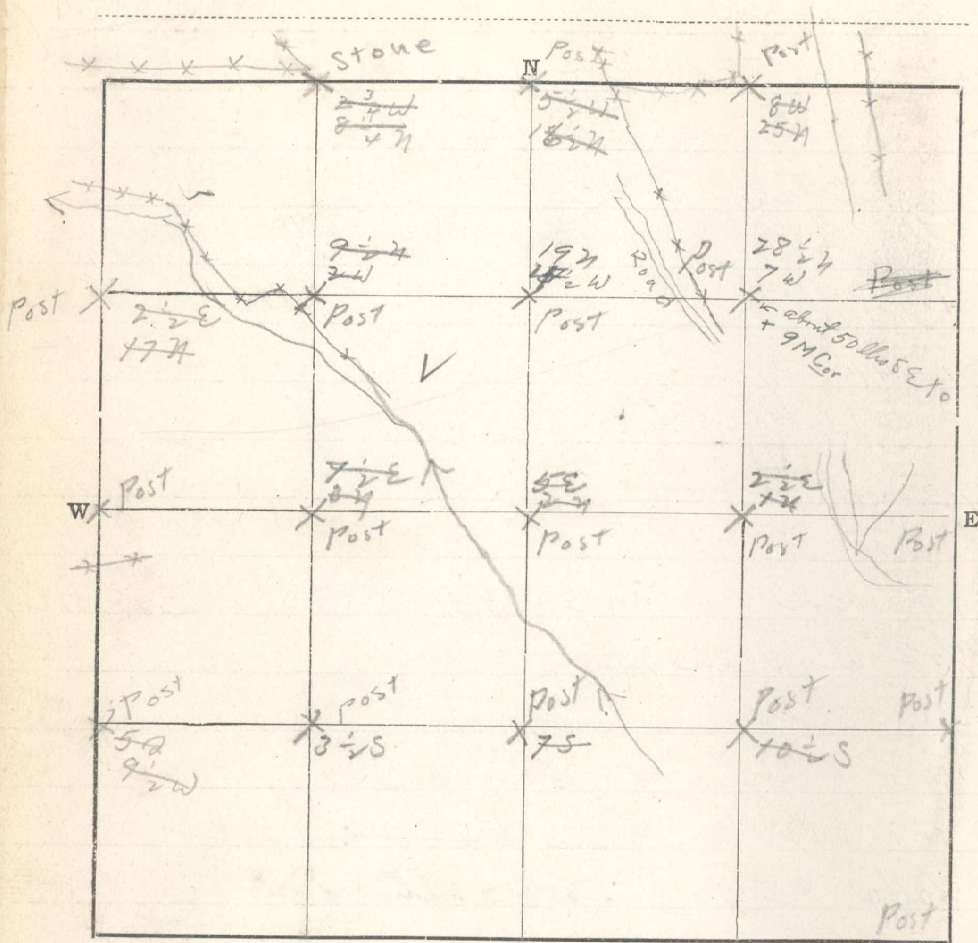

Scale 1320 ft. 1 in.

3/30 - From Cor

April 2 - E from Cor 15 - back night on 15-335

20

40

60

Back set in ground near 517

7999 Cor 12 bears 514 lbs

3/19
A from Cor 3 near 25, 26, 31 + 36

330

20 set stake

3966 1/4 Cor but 25 + 36

1987 Mound of stone ^{with stone in center} bears W 15 lbs.

20 set stake

4010 Cor 4 - 536 bears W 19 lbs.

From Cor 1 - 536 near E

20 set stake

40 set stake

60 set stake

7989 Cor 2 - 536 bears N 33 lbs

April 2 - W from 6 - 536

20

2002 - Stake set / bears S 12 lbs.

40

60

7990 Cor 8 bears N 4 lbs.

4/3 - E from Cor 16 - back night on Cor 7 - 535

20

40

60

7991 Cor 11 bears N 38 lbs