


Sec. 11 T. 2 R. 38 E
 Examiner _____ Date 4/19 19__

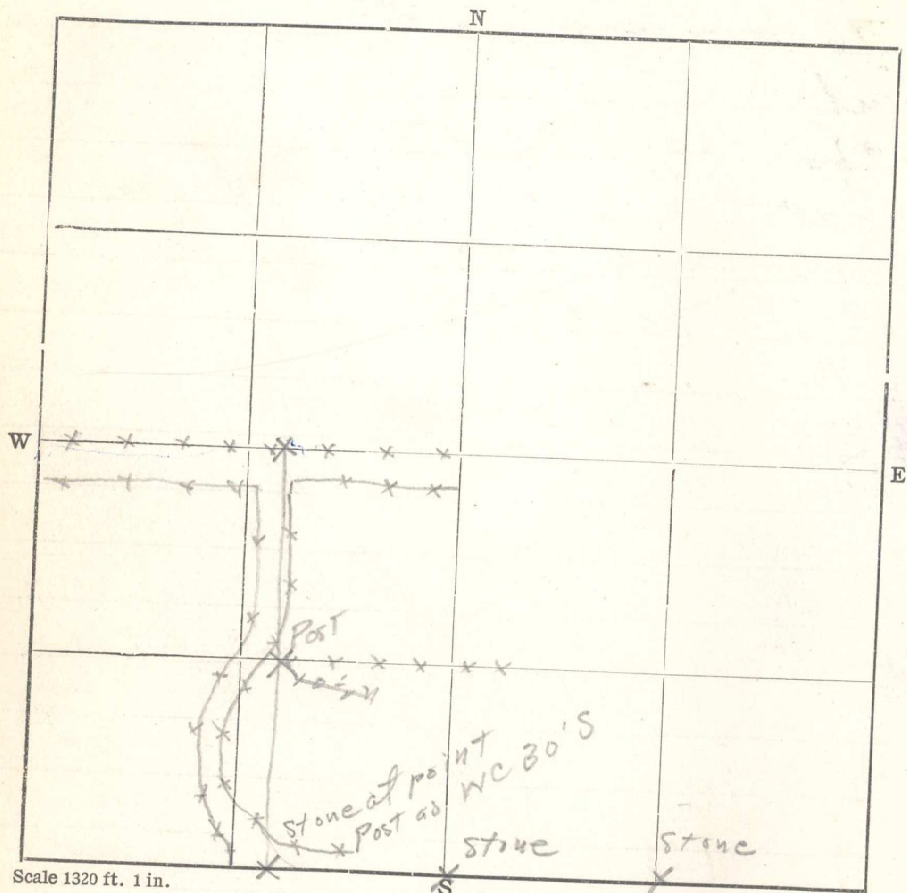

From Cr 8 run S
 4019 Cr 4 - drop post set as Cr
 E from Cr 4
 2338 Fence N + S
 24 + 0 p set stakes

40 set stakes
 4019 Fence N
 60 set stakes
 7996 Cr 3 bears N 40 chs.
 April 4 -
 N from Cr 24 chs E of Cr 4
 20 set stakes 2010 fence running E
 4021 Cr 24 chs E 78-571 - Cr School fence

335