


Sec. 10 T. 2 R. 33

Examiner \_\_\_\_\_ Date 4/4 19\_\_\_\_

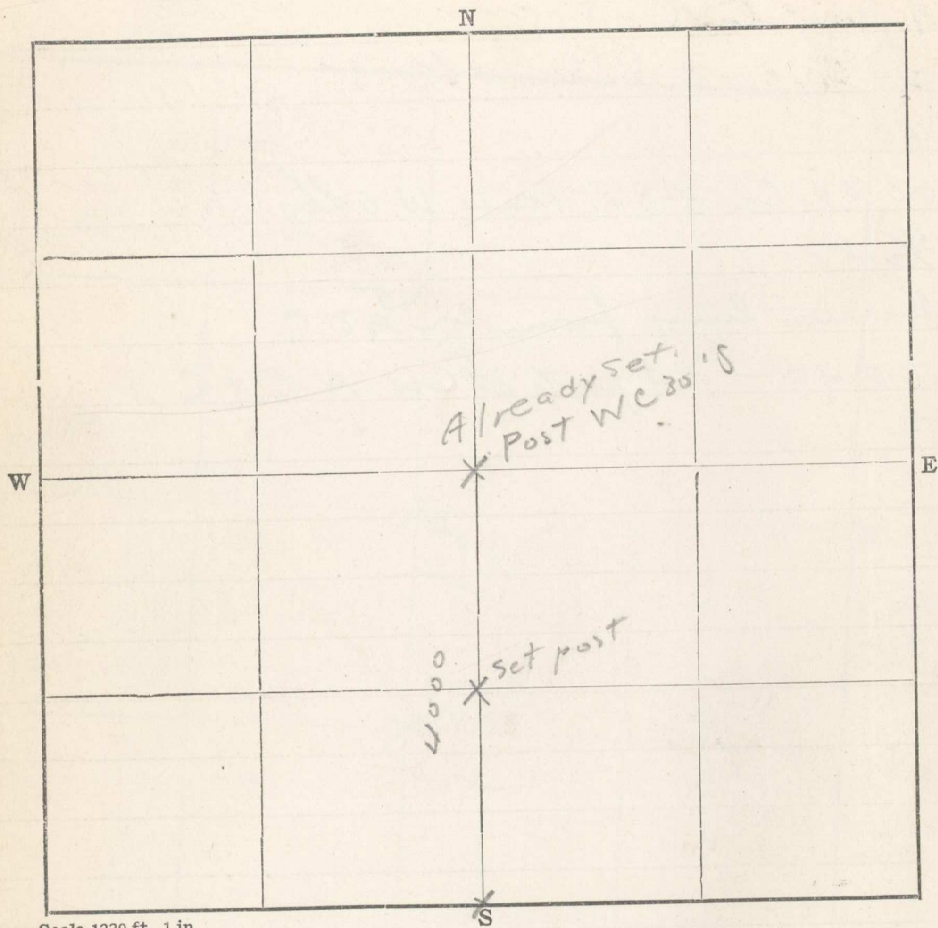

Scale 1320 ft. 1 in.

21 from Cr 7-515

1957 Fines W

1974 Fines E

338

20 outtakes

40 Cr 0-510 beam E 1/2 lb.