


17  
Sec. 2 T. 2N R. 34E

252

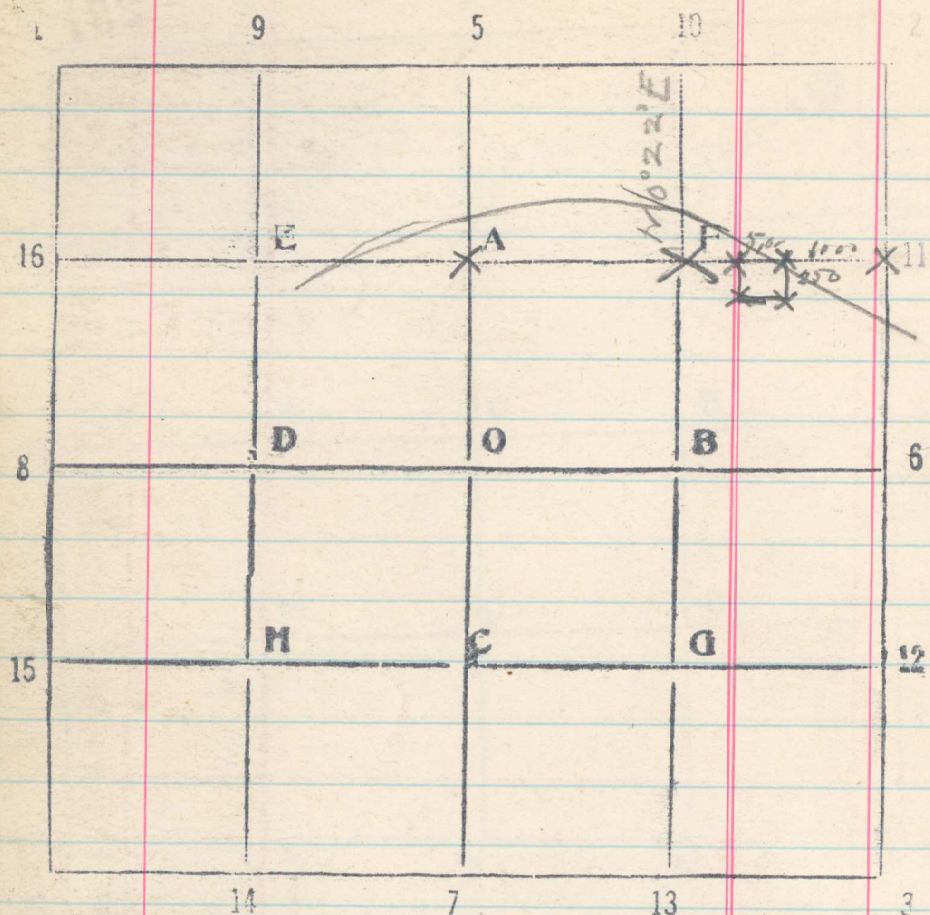

From 11-S. 2 run west

10.04 Set cor. for N E cor of cemetery

15. Set cor. for NW cor of cemetery

20.68 Cor F-S. 2 bears N. 41 lks

40.16 Cor A-S. 2 on line

July 13, 1917