

45


Sec.

7

T.

2

R. 34

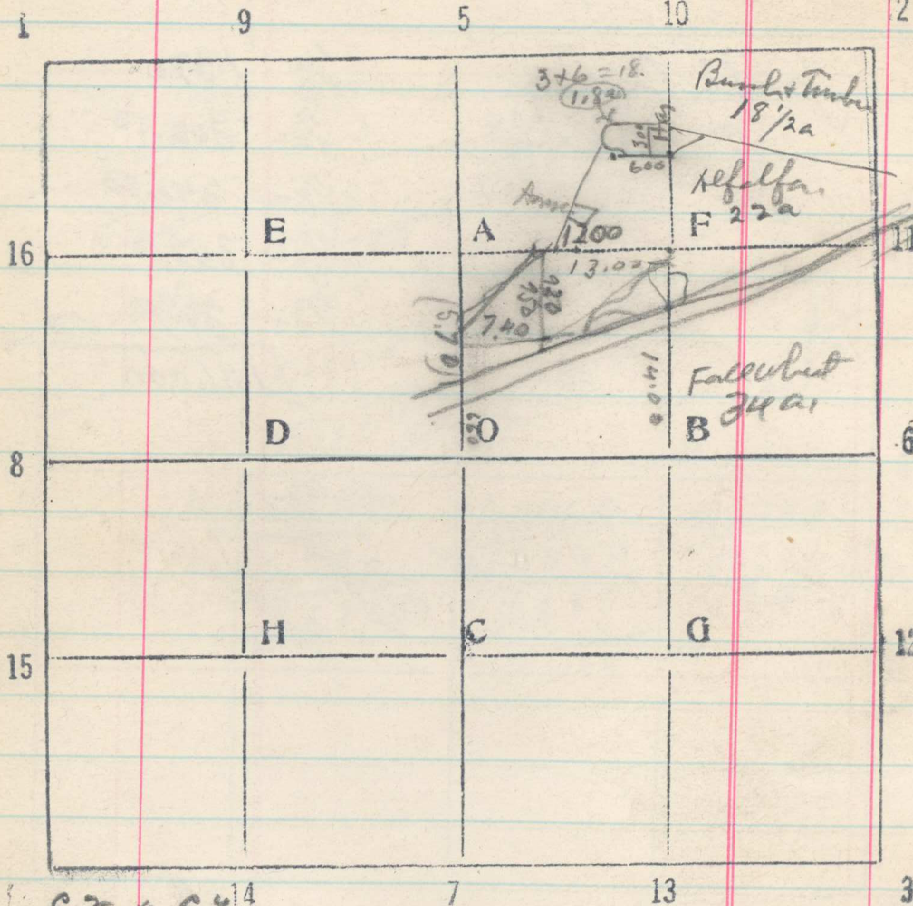

Alfalfa	22.
Fall Wheat	34.
Bottom land not cultivated	19
RR R/W	75
Bluff + road	8.2
Total	158
	8000

327

W² N E⁴ 7-2-34, 800a,

C-100 Inheritance,

Alfalfa,

21. a.

Cultivated in N. part,

1.75

Cultivated just N. of R.R.

2.

Fall Wheat

20.50

Total farmed,

45.25 a

Horse yard in alfalfa field .2

Hay corral .6

Brush in E. part .25

River + brush, N. part 30.5

Total river, brush + corral 31.35

31.55

Area in C-W, R+N, R/W,

320

Total

8000a.

Feb. 24, 1920