


Sec. 16 T. 2 R. 34

Examiner \_\_\_\_\_ Date 4/27 1918

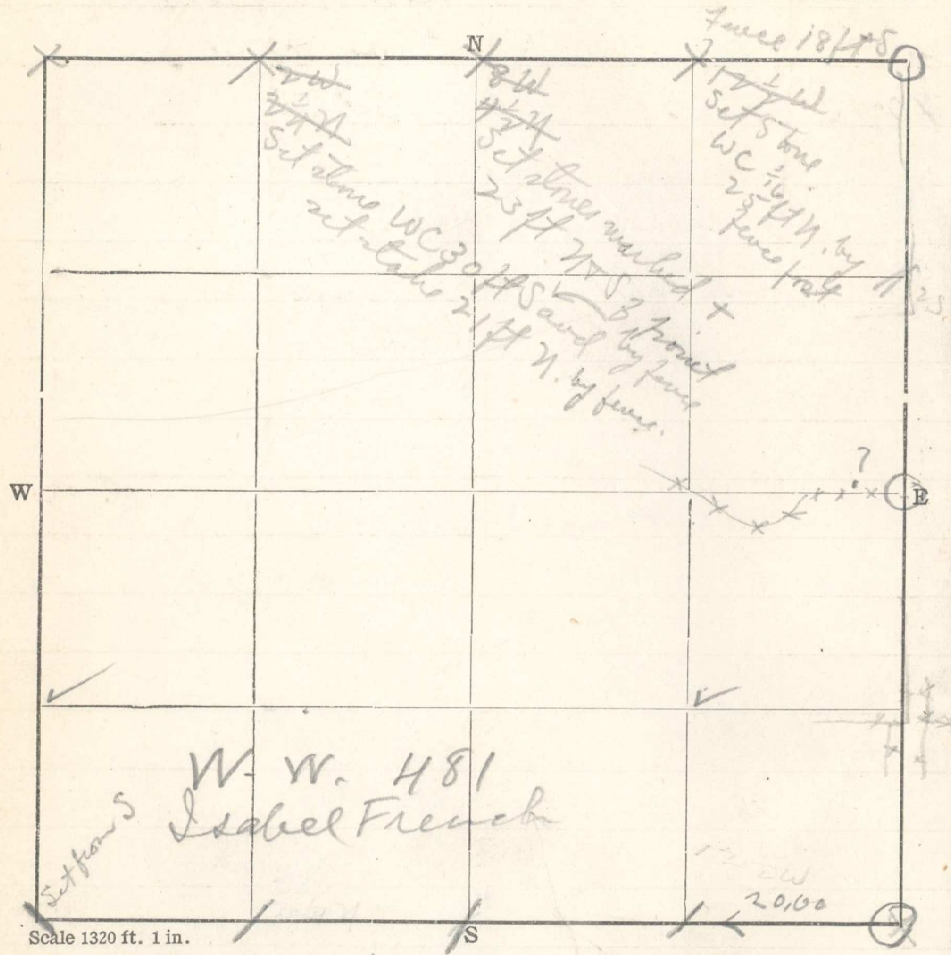

2 from Cor 1 that I have established  
 1998 Fence S  
 20  
 40  
 60  
 7982 Cor 2 bears S 4 lbs  
 at 40 turn  $1^{\circ}45'2''$  to keep in line  
 fence m's 30 lbs on N 39 lbs  
 5977 fence m's

5/7 - S from Cor 2  
 20  
 40  
 60  
 8023 Cor 3 bears W 6 lbs.  
 + 53 fences W about 10 lbs  
 + Rock (Cor) bears E 4 lbs.  
 + 52 fences E + W