Sec. 13 24 T. 2 N R. 35

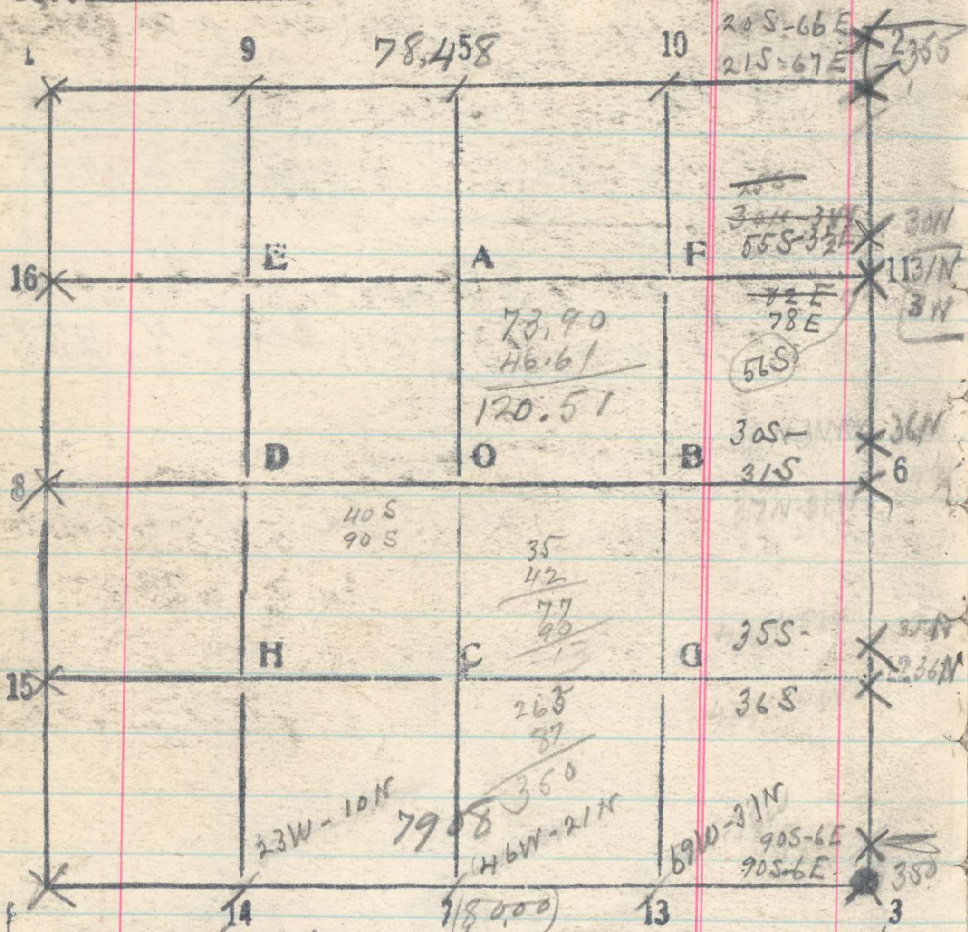

From temp cor of secs. 18 & 19 run South on same line

3.55 Set cor of secs. 13 & 18
+.38 temp CC of 18 & 19 set from W
3.93 bears E. 220 lks

20 Set 1/16 cor for sec. 19. July 2, 1919

23.55 Set 1/16 cor. 11 for sec 24
40.00 No trace of 1/4 cor. Set 1/4 cor 24 & 19
43.53 Set 1/4 cor 24
60 Set 1/16 cor. 15 - S. 19
63.61 Set 1/16 cor 12 - S. 24
~~62.38~~ ~~Offset west~~
73.90 Flag. set 46.61 chs. N of 1/4 cor on W. bdy sec. 30
80 Set cor of 19 & 30

Thence South on same line
3.03 Cor of secs. 24 & 25 bears W. 6 lks.
(3.50) a stone in mid stone
~~47~~ marked 1111 on N & 11 on S.
July 9, 1919