25

Sec. 33 T. 2N R. 3E

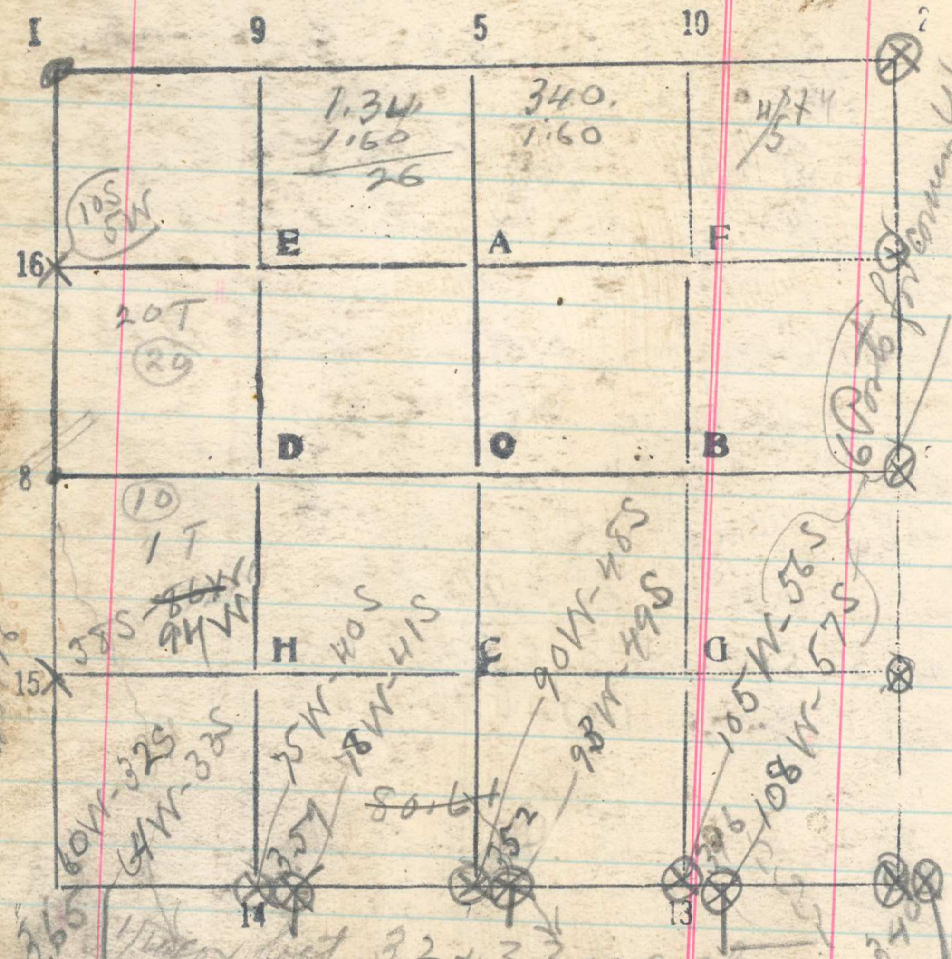

East on S bdy sec. 33

9.50	Canyon S 20° E
20.	Set 1/4 - S. 33 T. 3 S. R. 3 E.
23.59	Set 9 - S. 4 260
28.	Dec. steep E. slope
40	No trace of 1/4 cor for Sec 33
43.53	Set 1/4 cor for sec. 4
43.75	Canyon S E. arc
54.25	Ridge, slope S 70° E
56.85	Head of gulch S 80° E
60	Set 13 - S. 33
63.46	Set 10 - S. 4
68.00	Ridge, slope S E
75.00	Set stake 7 pts to Comp
~~80.00~~	~~Set stake for cor of 32 + 33~~
81.32	~~A pile of rock, no marks, bears S 15° W 66 lks. S. stake for evidence cor of 32 + 33~~
	From 1/4 cor bet 32 + 33 July 23 by D Son rec cor
20 39.80	Set 1/4 Cor of Secs. 28, 29, 32 + 33 a stone + Remains of MS. bears W. 10 lks Oct 2, 1919

365 Thence bet 32 + 33 no stone no marks discernable in MS. Tree 22" S 76½° W 113 lks mkd 1/4 S old notes say S 65° W 167 & 107

Thence South bet 32 + 33

2000 Set 1/4

40.76 Temp Cor of secs 32 + 33 bears W 128 lks

Cor 32 + 33 bears W 172 W