



35-24 T. 2 - 36

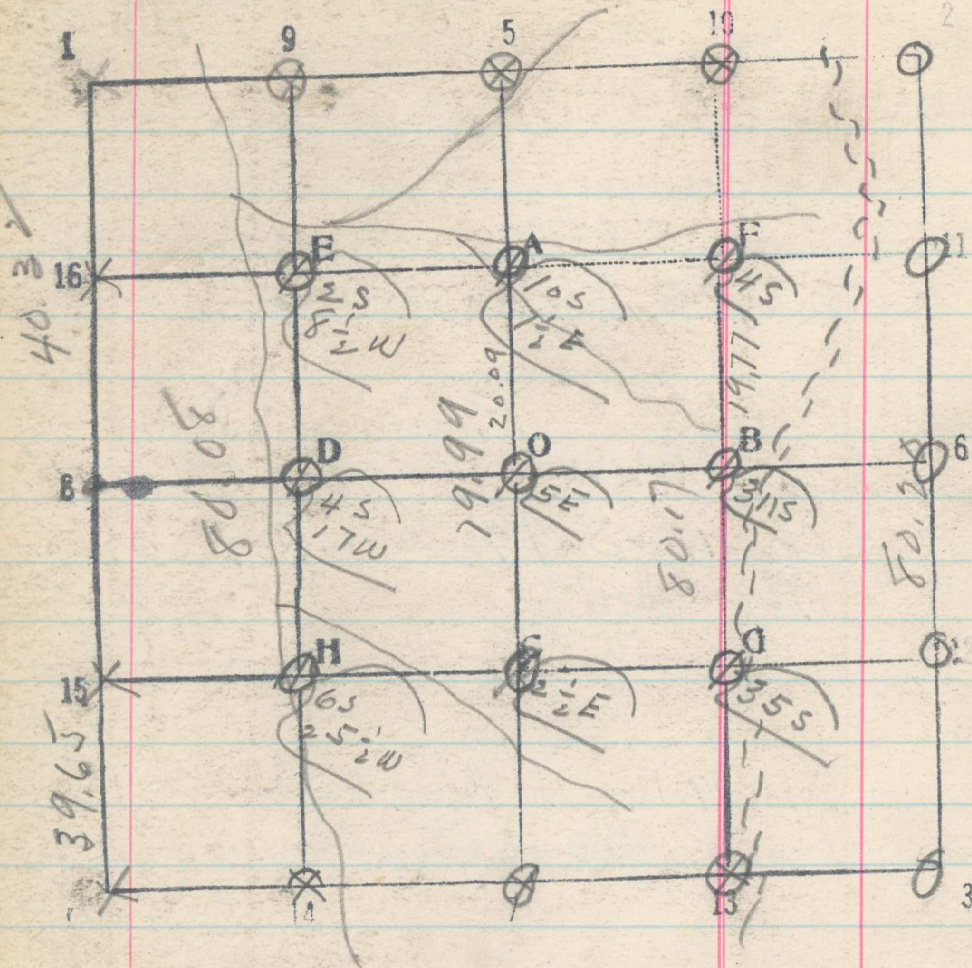

25 T. 2 R. 35 270

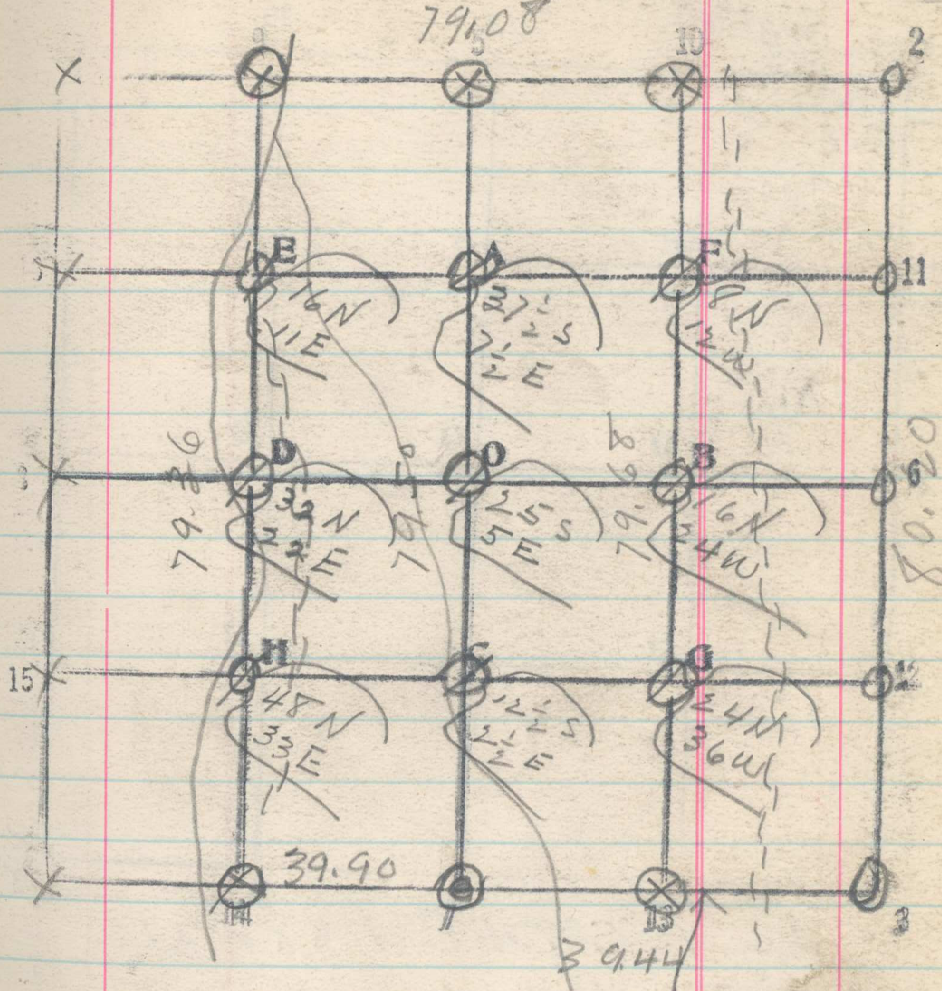

Chump of Trees