


Sec. 47 21 T. 2N R. 35E

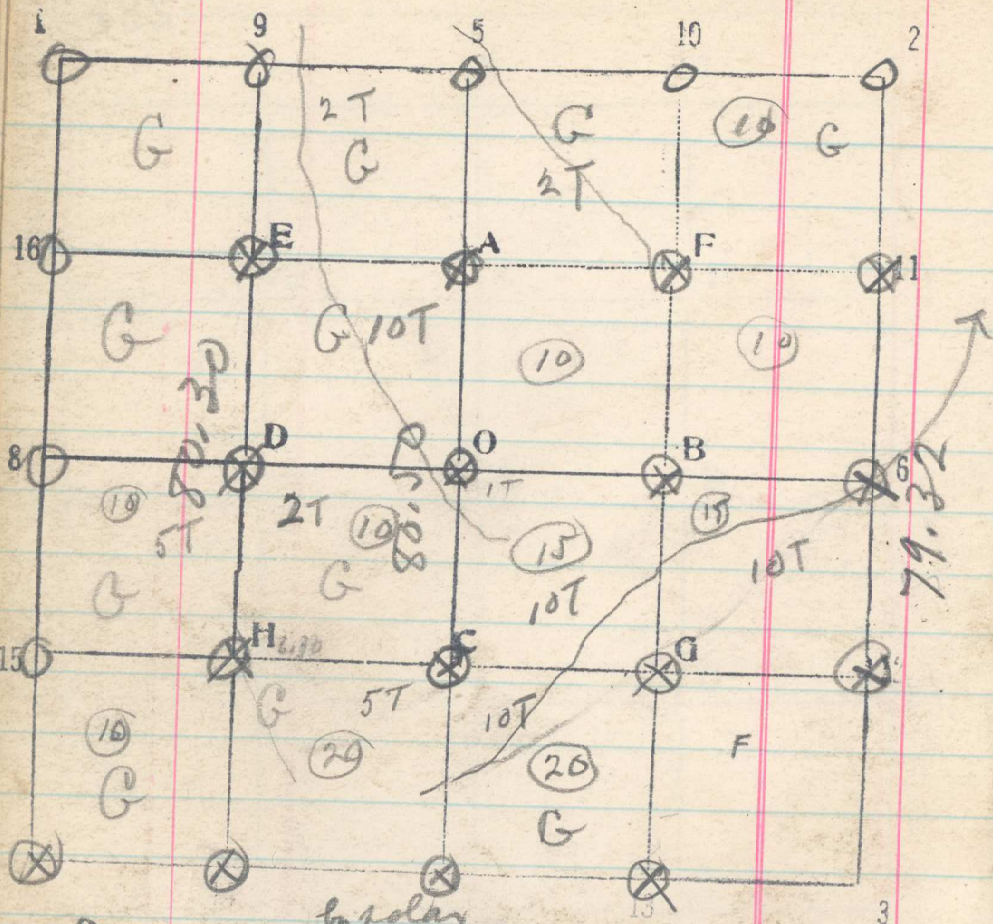

Line 14-9, Set 20, 40 + 60  
 80.30 Cov 9 bears W, 84 lks. Oct. 29, 1919

Line 7-5 Set 20, 40 + 60  
 80.50 Cov 5 bears W, 64 lks

Line 10-13, Set 20, 40 + 60  
 Cov 13 bears