


4
 Ser. 25 T. 2N R. 35E

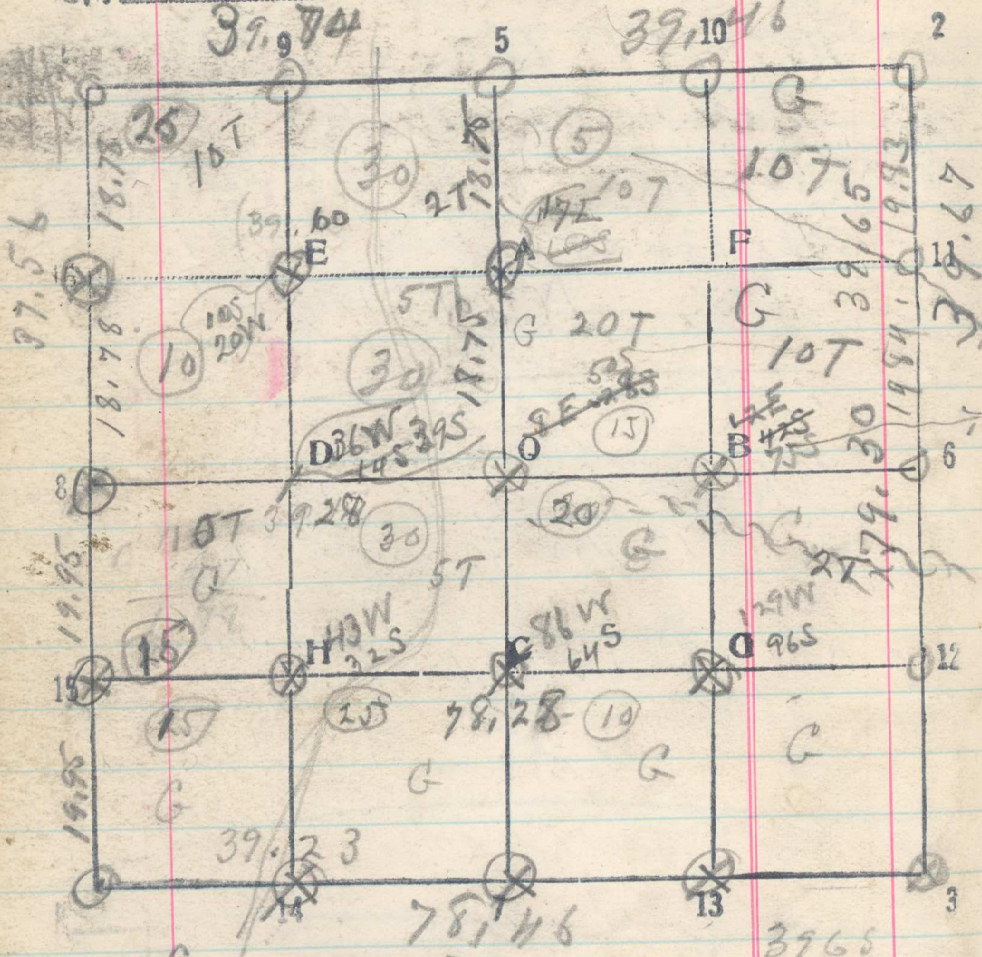

Line 8-6 Set, 20, 39.20 + 38.50
78.56 1/4 cov bet row 27 + 28 bears 5.58 lks

Line 0-5
 Set A-S, 28
 Cov 5 bears 5.48 lks

NOV 12, 1919

Line 16-A.

20
 39.60 Set temp E. 20 lks
 39.57 Cov A bears 5.20 lks Nov. 8, 1919
 Line 16-12 Set. 20.4 or 60
 78.28 Cov 12 bears 5.128 lks.