


42
Sec. 10 T. 2 R. 35

Examiner Date 19.....

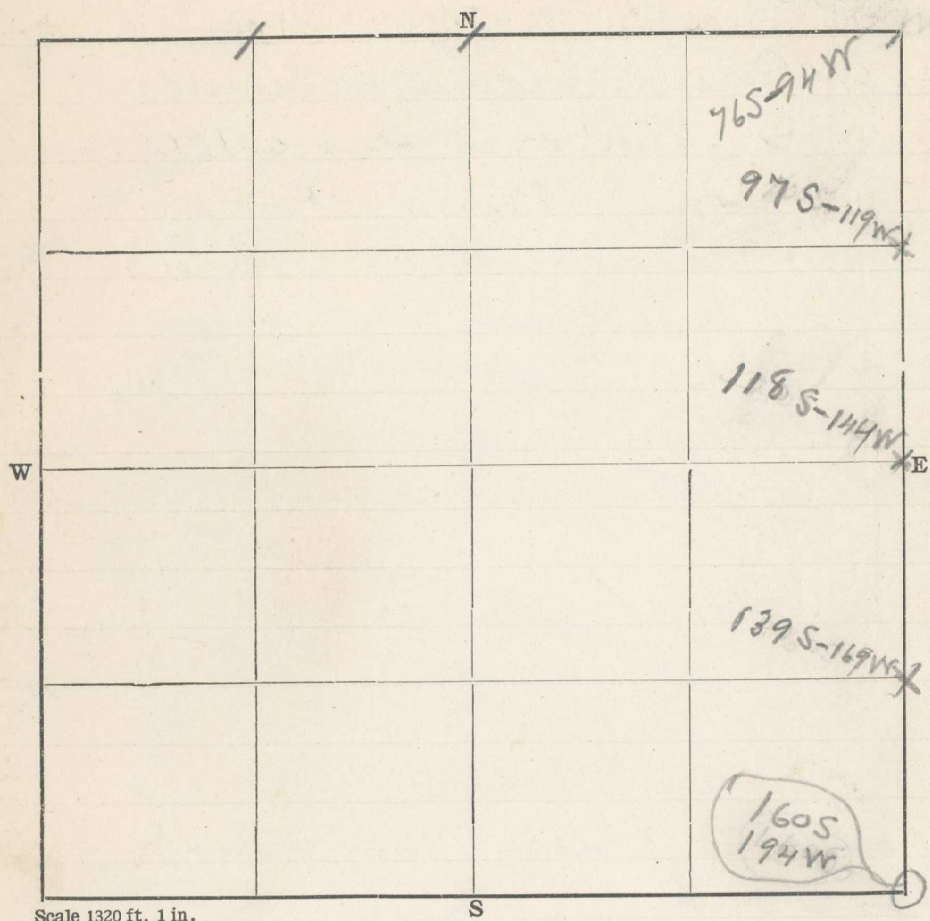

From random cor. to secs 2, 3, 10 & 11 run

South bet secs 10 & 11

20.00 Set term $\frac{1}{16}$ cor

374

40.00 Failed to find $\frac{1}{4}$ cor. - Set term $\frac{1}{4}$ cor

60.00 Set term $\frac{1}{16}$ cor

81.60 Original cor to secs 10, 11, 14 & 15

bears W. 194 lfs dist (Aug 15)