20

Sec. 5 T. 2 N R. 36 E

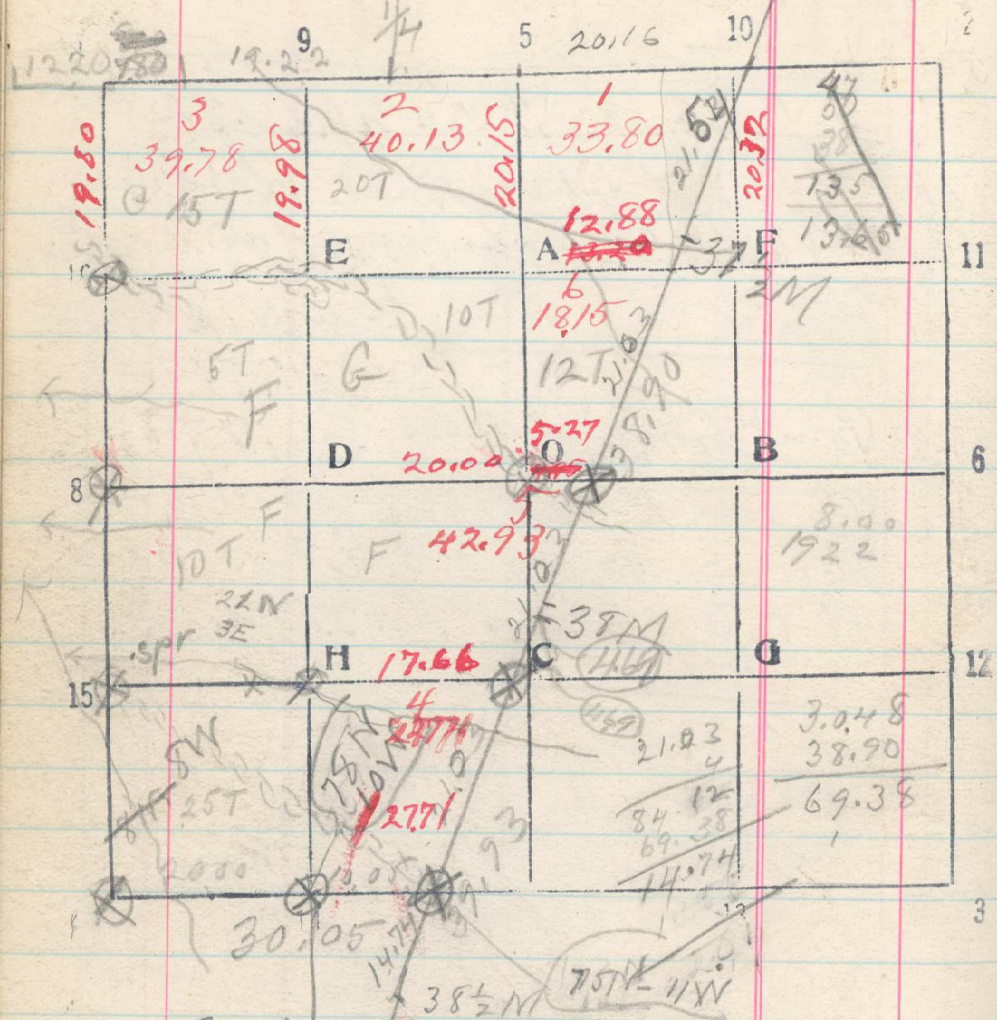

East bet 5 & 8, from temp cor of secs. 5, 6, 7 & 8 set from W.

7.25 Boston Canyon, N 10° W

20 Set 14 - S. 5

302

30.05 No trace of CC, Set temp stake,

30.15 C.C. of secs. 5 & 8 as reestablished by one beam N. 113 lks. dist.

14.74 From 38½ M cor run N 20° E

~~13.65~~ Intersect random line bet secs 5 & 8, & set stake, Dec. 2, 1919

From cor. 15 run East

3)113
38
2
76

113 N
41 E
~~188 N~~
~~68 E~~

20 Set H - S. 5

(37.66)
37.70 Cor. bet Lots 4 & 5 bears N. 40 lks.

21.03
4
84.12
14.74
13.53
1.21

From CC bet Lots 5 & 6 run West,

5.27 Set cor O on line with ¼ cor. 8

Thence North toward ¼ cor. 5

.75 Ridge, slope NW. disc steep N slope

20. Set A.

23. Creek, N W.

28 Canyon W.

40.04 Intersect ¼ cor on N bdy, Dec. 31, 1919
(40.15)

27°	1.00	11
35°	3.00	54
32°	5.00	76
28°	3.50	41
26°	1.50	15
21°	5.00	30
		327