26

Sec. 7 T. 2 N R. 36 E

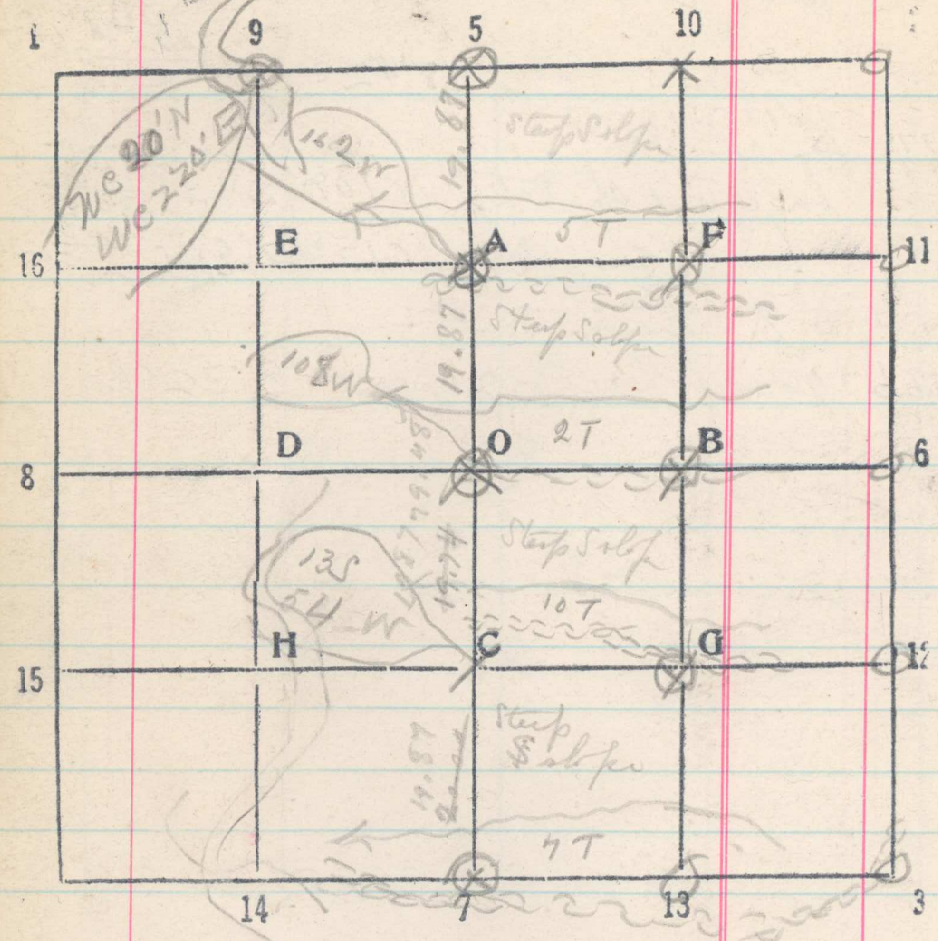

Line 10-13 Set 2 Posts

7928 Cor 13 bears W. 42 lks. Jan 1. 1920

Line 7-5

70 Set Temp C.

32. Camp. W.

39.74 Set temp D. (30 lks N & about 20 of temp D. each 74)

57. Ridge W.

308

59.61 Set A.

79.48 Temp 1/4 cor bet 6 & 7 bears W. 1 1/4 lks.

Correct 1/4 cor bet sections 6 & 7 bears

W. 216 lks. W.

1/2/20