

30

35 1992  
 24  
 1919  
 .72

Sec.


32

T.

3N

R.

34E

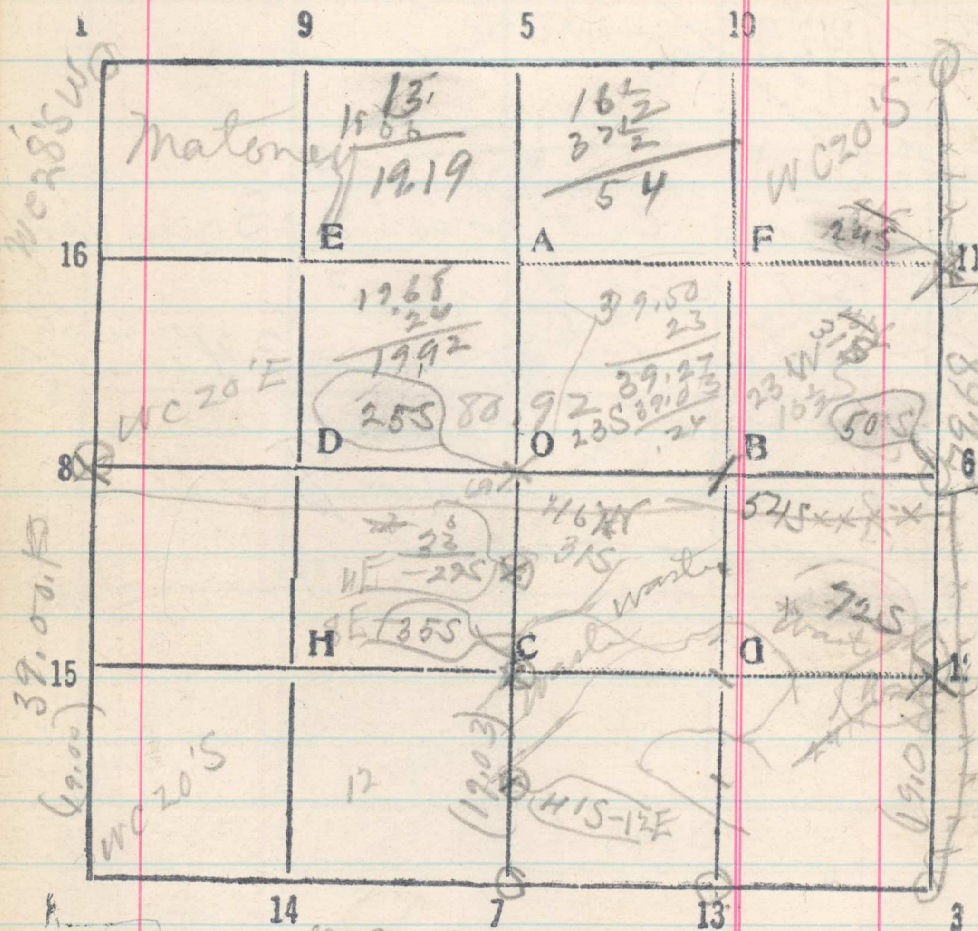

North of sec 31 & 32

38.83 On line with fence to S

38.93 On line with fence to W

39.13 Set temp gauge (32 lb difference to E)

79.26

Point for cor of sec. 29, 30, 31 & 32  
 intersection of cross roads  
 Set iron post for W C. 28 ft,  
 S'W, on line with fence to N  
 on W side of road and on line  
 with fence to E, on S side  
 of road.

Fence to S is about 5 ft to E, and  
 fence to W is about 3 ft to W of  
 this post.

Thence East

81.06 On line with fence to S. Set corner

81.24 On line with center of road to N

Thence East 81.06 to center of road

South bet 32 & 33

28.24 ~~Set of fence corner~~

N + E, bears E, 18 lbs

100 Set 1/4 cor

60 Set 1/16 cor

79.68 Intersection cor of sec 32 & 33

(79.06) Line 8-8 - 80.6 2 1/4 cor bears S 62°

39.50 Line 0-7, Fence 24 W, 69 lbs S, of O. Set 10.20 & 30  
 1/4 cor bears 10 lbs