


31
Sec. 33 T. 2N R. 34E

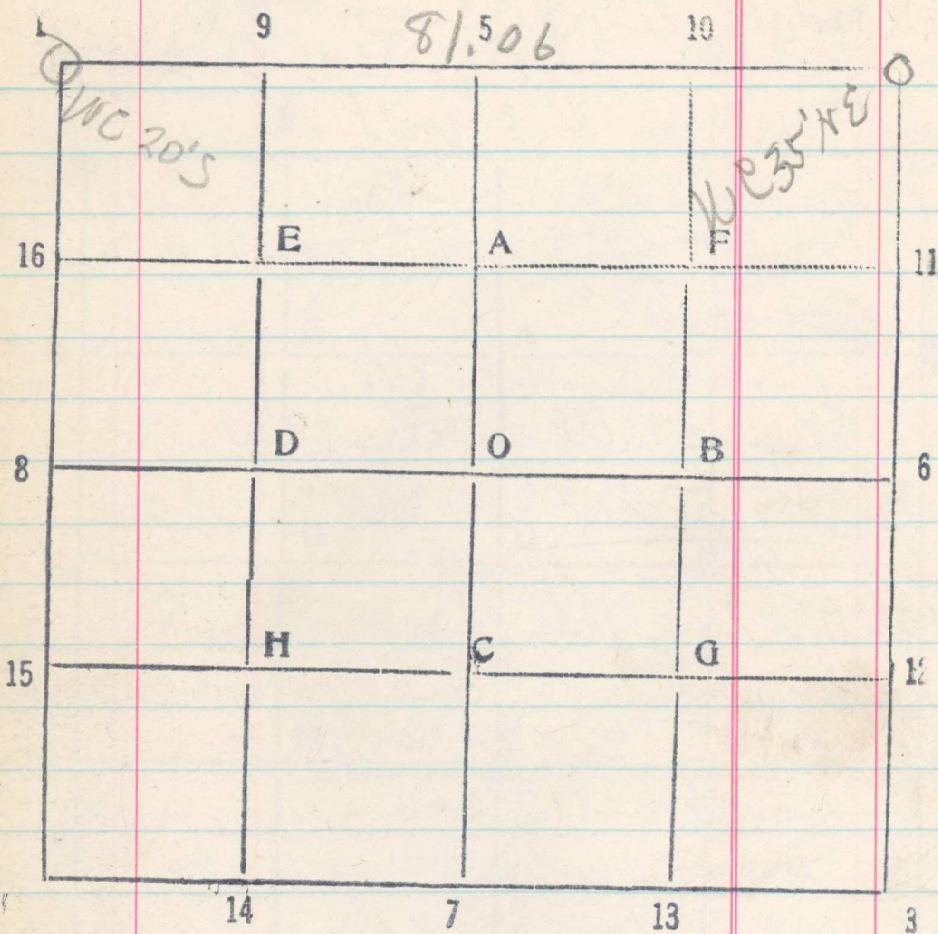

313