


44 22+33 3 35

1 9 5 10 2

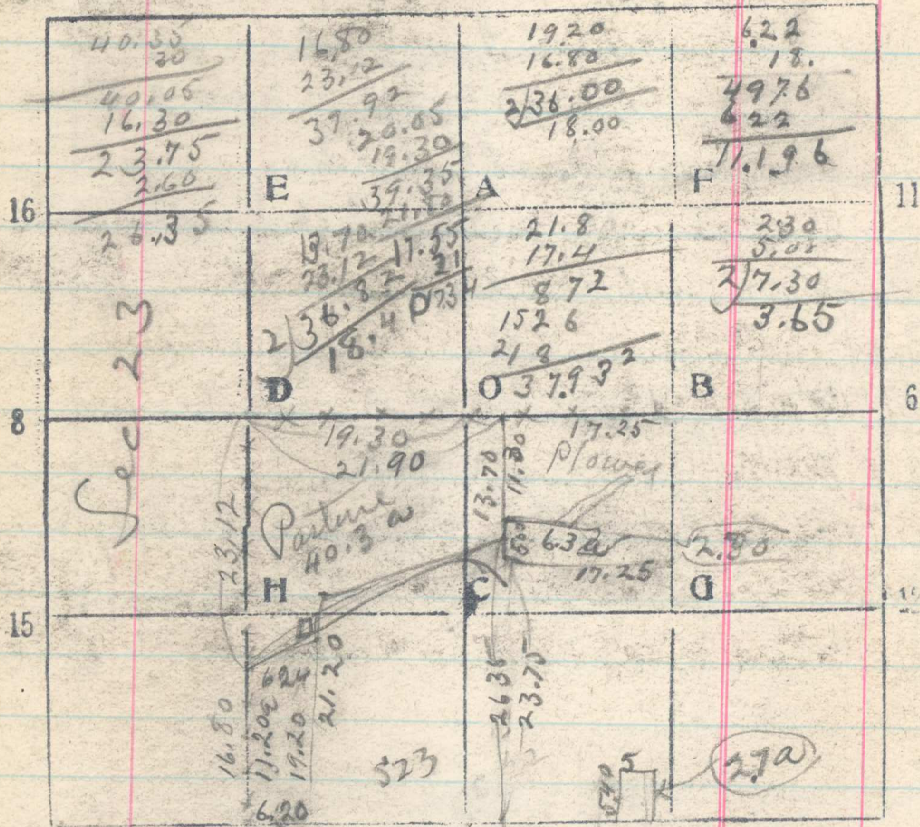

18.40
 21.90
 165600
 184
 368
 40,29600
 Pasture
 Hay ground
 Road
 Total
 526
 2.7
 40.3
 6.3
 49.3
 11.2
 60.5
 2.0
 62.5
 527
 17.25
 3.65
 56.25
 103.50
 517.5
 629625
 523
 27a
 5403
 2700

38.52
 38.43
 76.95
 80.00
 156.95
 62.54
 94.40 Plowed
 Total Area of allotment 156.95a
 Pasture 40.3
 Waste 6.3+2.7 9.0
 Road 2.05
 Hay ground 11.2
 Total to deduct 62.55
 Total area of tillable land 94.40a

40.30
 1200
 60.59
 2.04
 62.54
 121
 40
 840
 1.2
 2.04
