


Sec. 19 T. 3 N R. 36 E

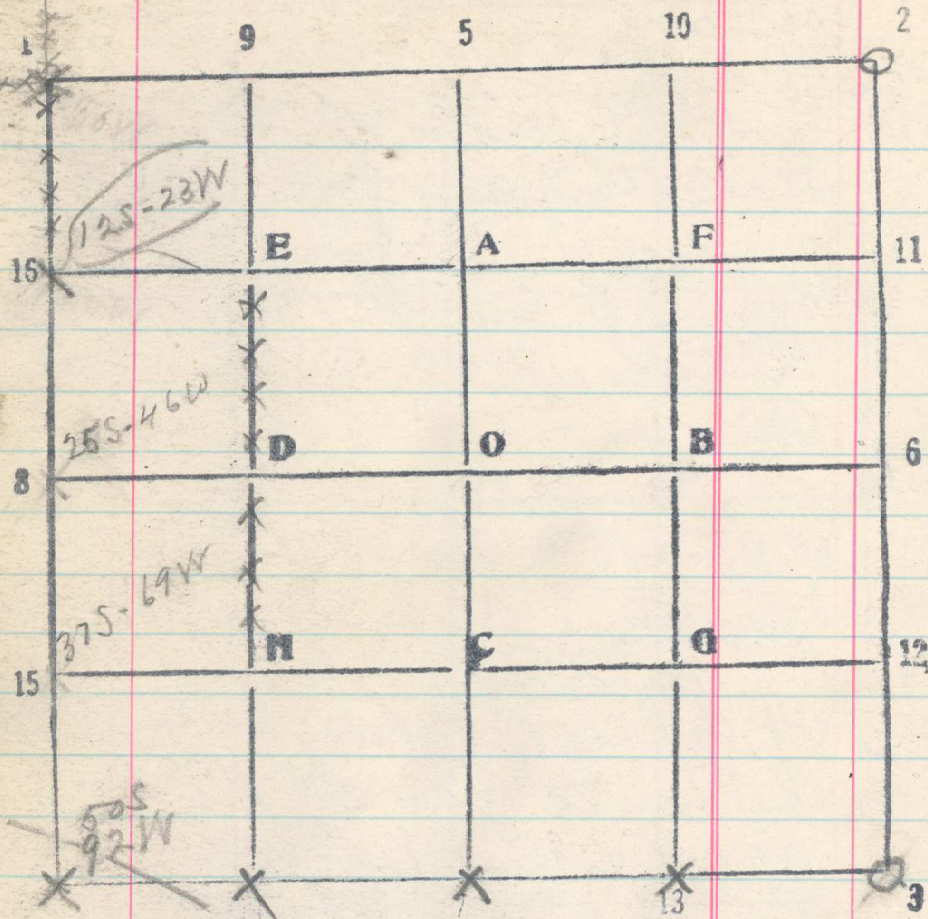

South by solar bet 19 + 24

20 Set  $\frac{1}{2}$  in grain field

40 Set  $\frac{1}{2}$  cor in grain field

60 Set  $\frac{1}{2}$  cor in grain field

69.56 Line of plowing, E + W

81.02 Temp set. cor. set from South bears W. 12 $\frac{1}{2}$  lbs  
Set temp cor.